


Section 12 Township 18 Range 14-W

Well No. #3, McCauley

Company Harndon Drilling etal

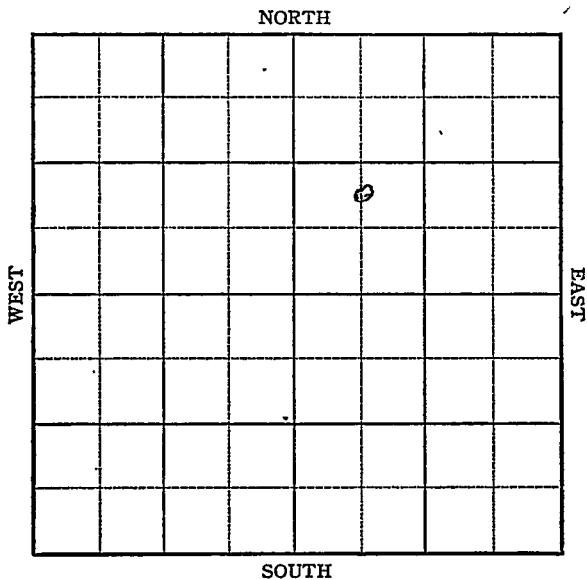

KANSAS

Barton ✓

Sec. 12 Twp. 18 R. 14W

Well No. 3 McCauley Farm

H erndon Drlg. Etal Company

Evelaigh Pool


 Ft. from N. Line

990 Ft. from S. Line

 Ft. from E. Line

660 Ft. from W. Line

C N L SW NE

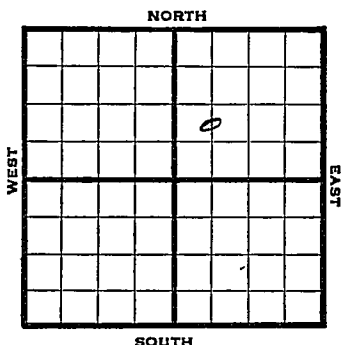

1946	Elev. 1884	REPORT		
11/27	RUR			
12/3	8" @ 906'			
	Anhy 799'			
	Drlg 3160'			
12/10	13" @ 115'			
	Drlg 815'			
12/17	Anhy 822'			
	8 " @ 835'			
	Drlg 2790'			
1947	/			
1/4	Arb 3352-56 TD Rotary			
	5" @ 3352'			
	TD 3363'			
	Swb 25 oil PH 8 hrs.			
1/8	"	"	"	
1/15	"	"	"	
1/21	"	"	"	
1/29	TD 3363'			
	Arb 3352			
	5" : 3352			
	Pump 375 Pot.			
	37 Gravity			
COMPLETED				

Map No. 73 Sec. 12 Twp. 18 R. 14W

Well No. 3 McCauley

Herndon Drlg. etal. Company

FIRST REPORT Contractor

C N L SW NE

SECTION PLAT

 Ft. from N. Line

990 Ft. from S. Line

 Ft. from E. Line

660 Ft. from W. Line

		o	

Barton County

Location

Rig up

Drilling and Remarks:

R U R

RECORD

Cased in, ft.

Sand

Gas

Oil

Total Depth

PRODUCTION

1st 24 hrs. Nat.

1st 24 hrs. after shot

Gas Cu. Ft.

Dry Hole

Abandoned

Date

NOV ' 27 1946

19

S. J. LEWIS

Scout

Map No. 73 Sec. 12 Twp. 18 R. 14W

Well No. 3 McCauley

Herndon Drlg. etal. Company

COMPLETE

Contractor

C N L SW NE

E 11884
SECTION PLAT

		0	

 Ft. from N. Line

990 Ft. from S. Line

 Ft. from E. Line

660 Ft. from W. Line

Barton County

Location

Rig up

Drilling and Remarks:

Act 43302
5703302
Pump 875 BX

37 1/2

RECORD

Cased in. ft.

Sand

Gas

Oil

Total Depth 2363

PRODUCTION

1st 24 hrs. Nat.

1st 24 hrs. after shot

Gas Cu. Ft.

Dry Hole

Abandoned

Date

JAN 29 1947 19 S. J. LEWIS Scout