

Map No. KANSAS Sec. 13 Twp. 18 R. 14²⁵

Well No. 1 Wilson Farm
Dwell-Smith-Clark & Company

NORTH

WEST

EAST

SOUTH

E 1891

Location _____
Drilling Remarks _____

Rig Up _____
Drilling Remarks _____

RECORD

Cased _____ in. _____ ft.
Sand _____
Gas _____
Oil _____
Total Depth _____

PRODUCTION

1st 24 hrs. Nat. _____
1st 24 hrs. after shot _____
Gas _____ cu. ft. _____
Dry Hole _____
Abandoned _____

Map No. KANSAS Sec. 13 Twp. 18 R. 14^w

Well No. 1- Wilson Farm

Cluwell, Smith - Ash & Company

Mid West


660 Ft. from N. Line

_____ Ft. from S. Line

_____ Ft. from E. Line

660 Ft. from W. Line

19.32 E 1891 L.S.

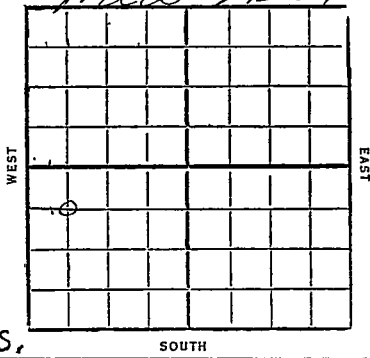

Date	REPORT
7/6	M.S.M.
7/13	
7/20	Reg
7/27	Regn up
8/3	Regd up & SD
	Regd water well
8/10	
8/17	Tag 276'
8/24	15" 335'
	Reg 700'
8/31	12" 835'
	SD 840'
9/7	TD 840' Cem hole
9/14	SD 848, Cem hole
9/21	Reg 1165'
9/30	Top salt 1292
	Base " 1580
	Reg 1930'
10/5	10" 1972
	Reg 2253
10/12	TD 2325 U/B 10"
10/19	

Barton

73 KANSAS

W

Map No. Sec. 13 Twp. 18 R. 14

Well No. 1 Nilsew

Elwell, Smith - ash & Mid-West Company

Contractor

COMPLETED

SECTION PLAT

o			

660 Ft. from N. Line

Ft. from S. Line

Ft. from E. Line

660 Ft. from W. Line

ABANDONED

Location

Rig up

Drilling and Remarks:

Top Cong 3367
HFW 3367-70Top Siliceous 3415
HFW 3418

RECORD

Cased in, ft.

Sand

Gas

Oil

Total Depth 3576

PRODUCTION

1st 24 hrs. Nat.

1st 24 hrs. after shot

Gas Cu. Ft.

Dry Hole ✓

Abandoned ✓

Date

DEC 7 1932

CHAS. L. SHERWOOD

Scout

73

KANSAS

Barton

Map No. _____ Sec. 13 Twp. 18 R. 14 W

Well No. 1 Wilson

Elwell, Smith-asw & Mio-Nest Company

Contractor

FIRST REPORTS

SECTION PLAT

660 Ft. from N. Line

_____ Ft. from S. Line

_____ Ft. from E. Line

660 Ft. from W. Line

0			

Location _____

Rig up _____

Drilling and Remarks:

moving in
material

RECORD

Cased _____ in., _____ ft.

Sand _____

Gas _____

Oil _____

Total Depth _____

PRODUCTION

1st 24 hrs. Nat. _____

1st 24 hrs. after shot _____

Gas _____ Cu. Ft.

Dry Hole _____

Abandoned _____

Date

JUL 6

1932

CHAS. L. SHERWOOD

192

Scout

10/26- TD 2325' UIR 10"
11/2- TD 2665' Rng 8"
11/9- 8"-2665'
drlg 3122'
11/16- 6"-3172
shaw water 3260-67
drlg 3290'
11/23 Conglomerate 3367-3412
HFW 3367-70'
5"-3380
Top Chic 3415
HFW 3418
drlg 3428'
11/30- " 3513'
12/7- Top Cong 3367
HFW 3367-70
Top Chic same 3415
HFW 3418
TD 3576
Dry & Abandon