

KANSAS

Section 14 Township 18 Range 14-W


Well No. #1 Skolant

Company Cities Service
Willard

NORTH

WEST

EAST

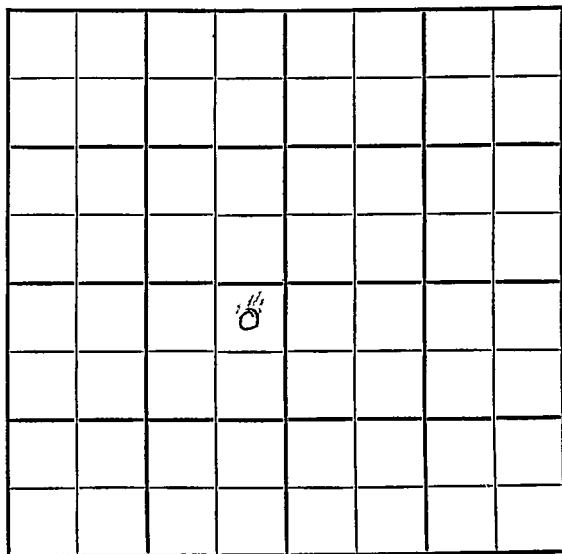

SOUTH

KANSAS

Barton



Sec. 14 Twp. 18 R. 14W

Well No. #1 Skelant Farm

Cities Service Company

Wildcat


330' Ft. from N. Line

Ft. from S. Line

330' Ft. from E. Line

Ft. from W. Line

NE SW

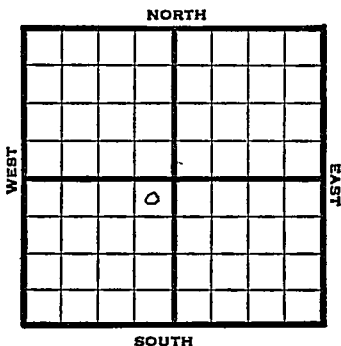

1948

Eli 1918'

REPORT

6/30 Location
7/8 Surface hole
7/14 8" @ 879'
Drlg 2780'
7/21 TD 3450'
Lansing 3133'
Arb. 3441'
Aband.

ABANDONED

Wildcat


Map No. 73 Sec. 14 Twp. 18 R. 14WWell No. 1 Skolant

Cities Service Company

ABANDONED

Contractor

NE SW

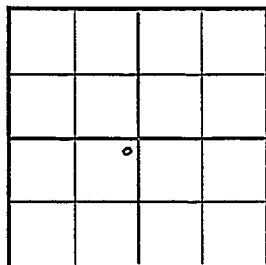E 11918
SECTION PLAT330 Ft. from N. Line Ft. from S. Line330 Ft. from E. Line Ft. from W. LineBarton CountyLocation Rig up

Drilling and Remarks:

*Same 913**As 9441*

RECORD

Cased in., ft.Sand Gas Oil Total Depth 3450

PRODUCTION

1st 24 hrs. Nat. 1st 24 hrs. after shot /Gas Cu. Ft.Dry Hole Abandoned

Date

JUL 21 194819S. J. LEWISScout

Map No. _____ Sec. 14 Twp. 18 R. 14W

Well No. 1 Skolant _____

_____ Cities Service _____ Company

FIRST REPORT

_____ Contractor

NE SW


SECTION PLAT

330 Ft. from N. Line

_____ Ft. from S. Line

330 Ft. from E. Line

_____ Ft. from W. Line

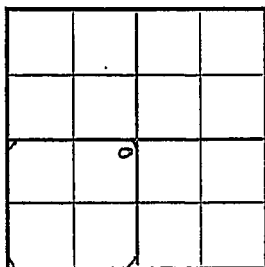

Barton Cou ty

Location X

Rig up _____

Drilling and Remarks:

RECORD

Cased _____ in., _____ ft.

Sand _____

Gas _____

Oil _____

Total Depth _____

PRODUCTION

1st 24 hrs. Nat. _____

1st 24 hrs. after shot _____

Gas _____ Cu. Ft.

Dry Hole _____

Abandoned _____

Date

JUN 30 1948 19 S. J. LEWIS Scout