


Map No. _____ Sec. 33 Twp. 27 R. 6
 Well No. 4 - Shriver Farm
H. H. Patton Company

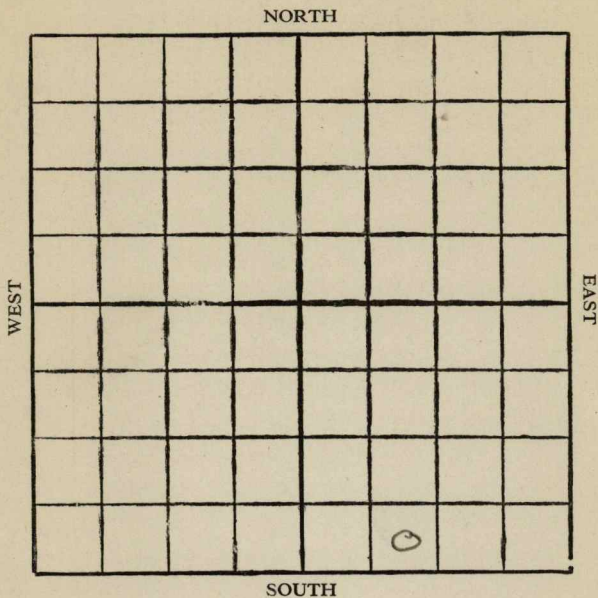

Location

Drilling Remarks

Rig Up

Drilling Remarks

RECORD

Cased in. ft.

Sand

Gas

Oil

Total Depth

PRODUCTION

1st 24 hrs. Nat.

1st 24 hrs. after shot

Gas cu. ft.

Dry Hole

Abandoned

Butler

Map No. Kansas Sec. 33 Twp. 27 R. 6Well No. 4 Shriver FarmH. H. Patton Company

NORTH

Ft. from N. Line

320 Ft. from S. Line

Ft. from E. Line

990 Ft. from W. Line

WEST

EAST

SOUTH

Date

REPORT

19275/25 Location6/1 Rig6/7 —6/15 —6/22 —6/29 —7/7 rig7/13 rigging up7/20 Rigged up + S.D.7/28 —8/4 —8/10 —8/18 —8/24 —9/1 —9/7 —9/14 —10/6 Rig abandoned

11 **KANSAS** *Butter*
 Map No. _____ Sec. *33* Twp. *27* R. *6*
 Well No. *4 Shriver*
H. H. Patton _____ Company

 Contractor

FIRST REPORTS**SECTION PLAT**

_____ Ft. from N. Line

330 _____ Ft. from S. Line

_____ Ft. from E. Line

990 _____ Ft. from W. Line

		0	

Location ☒ _____

Rig up _____

Drilling and Remarks:

RECORD

Cased _____ in., _____ ft.

Sand _____

Gas _____

Oil _____

Total Depth _____

PRODUCTION

1st 24 hrs. Nat. _____

1st 24 hrs. after shot _____

Gas _____ Cu. Ft.

Dry Hole _____

Abandoned _____

Date

MAY 25 1927

CHAS. L. SHERWOOD

192

Scout

11 **KANSAS** Sec. *33* Twp. *27* R. *6* *Butter* ✓

Well No. *4* *Shiway*
H. H. Patton Company

Contractor

COMPLETED

SECTION PLAT

----- Ft. from N. Line

330 ----- Ft. from S. Line

----- Ft. from E. Line

990 ----- Ft. from W. Line

ABANDONED

Location -----

Rig up -----

Drilling and Remarks:

Rig abandoned

RECORD

Cased ----- in., ----- ft.

Sand -----

Gas -----

Oil -----

Total Depth -----

PRODUCTION

1st 24 hrs. Nat. -----

1st 24 hrs. after shot -----

Gas ----- Cu. Ft.

Dry Hole -----

Abandoned *Rig* -----

Date

OCT 6 - 1927

1927

CHAS. L. SHERWOOD

Scout