

Barton


KANSAS

FORM 51 25M 3-49 PETROL

Section 15 Township 18 Range 14W

Well No. #1 Wondra

Company Francis Oil & Gas

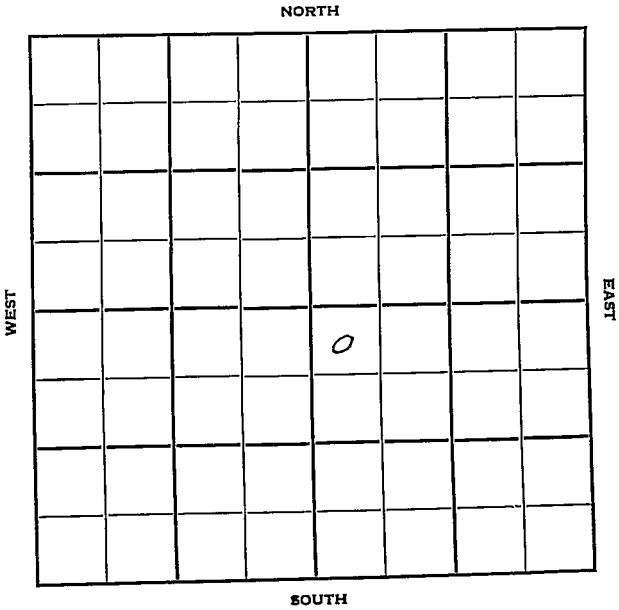

Barton
18

14W ✓

Sec. 15 Twp. R.

Well No. #1 Wondra Farm

Francis Oil & Gas Company

Contractor


330' Ft. from N. Line

Ft. from S. Line

Ft. from E. Line

330' Ft. from W. Line

NW NW SE

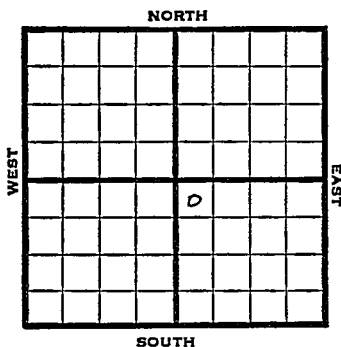

1950

Elev 1920' REPORT

4/12

Location

5/3

TD 3770'

8" @ 875'

Lans 3180'

Cong 3391'

Arb. 3438'

D&A

Aband.

ABANDONED

Map No. _____ Sec. 15 Twp. 18 R. 14WWell No. 1 Wondra_____
Francis Oil & Gas Company_____
Contractor


NW NW SE

SECTION PLAT

330 Ft. from N. Line

_____ Ft. from S. Line

_____ Ft. from E. Line

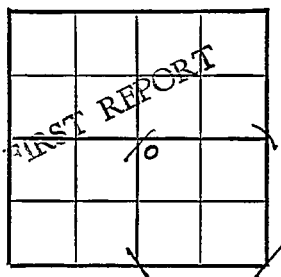330 Ft. from W. Line_____
Barton CountyLocation X

Rig up _____

Drilling and Remarks:

RECORD

Cased _____ in., _____ ft.

Sand _____

Gas _____

Oil _____

Total Depth _____

PRODUCTION

1st 24 hrs. Nat. _____

1st 24 hrs. after shot _____

Gas _____ Cu. Ft.

Dry Hole _____

Abandoned _____

Date

APR 12 1950 19J. E. TYRA Scout

Kansas

Wildcat

Map No. _____ Sec. 15 Twp. 18 R. 14WWell No. 1 WondraFrancis Oil & Gas Company


Contractor

NW 1/4 SE

E.I. 1920
SECTION PLAT330 Ft. from N. Line

_____ Ft. from S. Line

_____ Ft. from E. Line

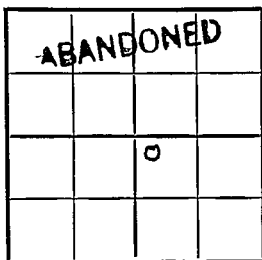330 Ft. from W. Line

Barton County

Location _____

Rig up _____

Drilling and Remarks:

8" @ 875
 Sand 3180
 Cong 3391
 Carb 3438
 D+A

RECORD

Cased _____ in., _____ ft.

Sand _____

Gas _____

Oil _____

Total Depth 3770

PRODUCTION

1st 24 hrs. Nat. _____

1st 24 hrs. after shot _____

Gas _____ Cu. Ft.

Dry Hole _____

Abandoned _____

Date

MAY 3 1950

19

J. E. TYRA

Scout