

Cowley

Map No. **KANSAS** Sec. 17 Twp. 31 R. 6^E

Well No. 1- Seamons Farm

Mission Oil Company


_____ Ft. from N. Line

660 Ft. from S. Line

660 Ft. from E. Line

_____ Ft. from W. Line

1930

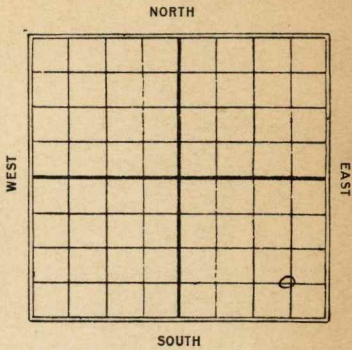

Date

REPORT

Date	REPORT
7/9	Bdy rig
7/16	Spdg.
7/23	drlg 300'
7/20	" 1000'
8/6	SIR 6"-1554'
8/13	SIR 6"-1735'
8/20	drlg 1900'
8/27	" 2150'
9/3	S. D. 2150'
9/10	Sandy line 2191-2221 show gas
	TD 2221
	Dry & abandon

2 **KANSAS** Sec. 17 Twp. 31 R. 6 E

Well No. 1 Seamans
Mission Oil Co Company

Contractor _____

FIRST REPORTS

SECTION PLAT

_____ Ft. from N. Line

660 Ft. from S. Line

660 Ft. from E. Line

_____ Ft. from W. Line

			0

Location _____

Rig up _____

Drilling and Remarks:

Blog Rig

RECORD

Cased _____ in., _____ ft.

Sand _____

Gas _____

Oil _____

Total Depth _____

PRODUCTION

1st 24 hrs. Nat. _____

1st 24 hrs. after shot _____

Gas _____ Cu. Ft.

Dry Hole _____

Abandoned _____

Date

JUL 9 1930

CHAS. L. SHERWOOD

19

Scout

Cowley

Map No. **2** **KANSAS** Sec. *17* Twp. *31* R. *6*

Well No. *1* *Seamans*

Mission Oil Co Company

Contractor

COMPLETE

SECTION PLAT

..... Ft. from N. Line

660 Ft. from S. Line

660 Ft. from E. Line

..... Ft. from W. Line

			0

ABANDONED

Location.....

Rig up.....

Drilling and Remarks:

D & a

RECORD

Cased..... in., ft.

Sandy *lime 2191-2221*

Gas *Show gas*

Oil.....

Total Depth *2221*

PRODUCTION

1st 24 hrs. Nat.....

1st 24 hrs. after shot.....

Gas..... Cu. Ft.

Dry Hole

Abandoned

Date

SEP 10 1930

CHAS. L. SHERWOOD

..... 192.....

..... Scout