


Section 6 Township 31 Range 4E

Well No. #1 Graham

Company Parker

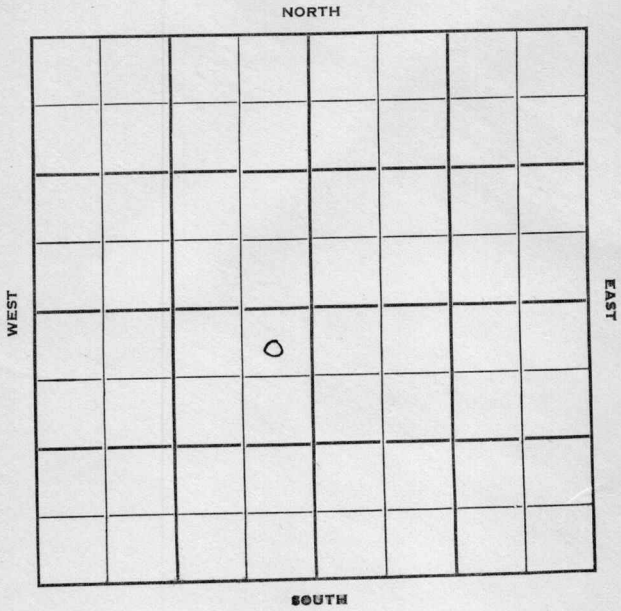

Cowley

KANSAS

Sec. 6 Twp. 31 R. 4E

Well No. #1 Graham Farm

Parker Company

Allison - Contr. Contractor


330' Ft. from N. Line

_____ Ft. from S. Line

330' Ft. from E. Line

_____ Ft. from W. Line

NE NE SW

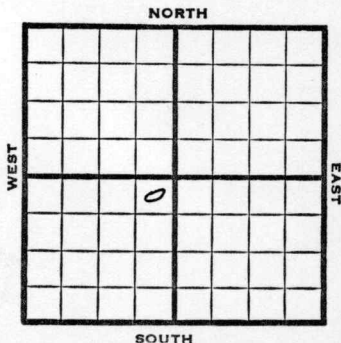

1951

Elev. 1151'

REPORT

10/17

Spud 10-8-50
Drlg. 2710'

10/24

Spud 10-8-51
8" @ 81 Miss 2924' Arb. 3284'
TD 3315' D & A

ABANDONED

