


Section 10 Township 31 Range 4E
Well No. 5 Houston
Company McNeish & Gralapp

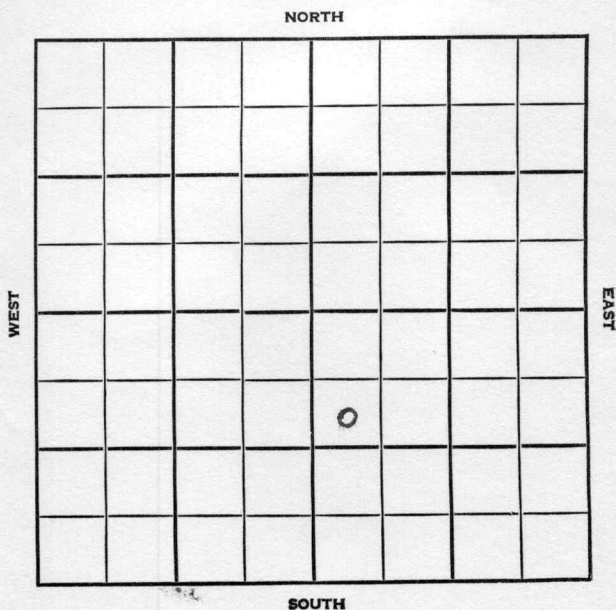

Cowley

KANSAS

SEC.	TWP.	R.
10	31	4E

WELL NO.

#5 Houston

FARM

COMPANY

McNeish & Gralapp

CONTRACTOR

Watson

990

David Pool


Ft. from N. Line

Ft. from S. Line

Ft. from E. Line

330

Ft. from W. Line

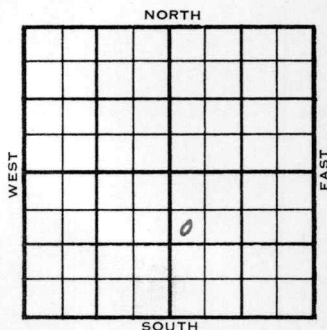

SW NW SE

1955

ELEVATION

1248'

REPORT

3/23

M I R

4/20

Spud 3-22-55 Oil well TD 2962
 8" @ 90 KC 2335 Oswego 2654
 Bart 2938' TD 2962 5" @ 2939
 CO to 2962 PB 2960 frac.
 Comp. 25 BOPD

COMPLETED

County Cowley State Kansas
 Sec. 10 (Blk. 31) (Sur. 4E) Map No. _____
 Operator McNeish & Gralapp
 Well No. 5 Farm Houston
 Elev. _____ Location SW NW SE

990 Ft. From N Line SE
330 Ft. From W Line Quarter

1st. Report MAR 23 1955

Completion _____

Remarks _____

Watson - Contr.

Spudding Date _____


Drlg. Data _____

David Pool

M I R

FABEN GILSTRAP

County Cowley State Kansas
 Sec. 10 (Blk.
Twp.) 31 (Sur.
Rge.) 34E Map No.
 Operator McNeish & Gralapp
 Well No. 5 Farm Houston
 Elev. 1248 Location SW NW SE

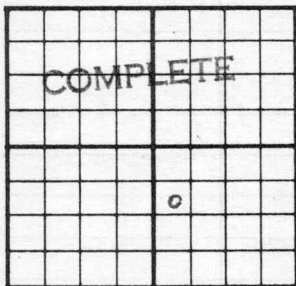

990 Ft. From N Line SE
330 Ft. From W Line Quarter
 1st. Report _____
 Completion APR 20 1955
 Remarks David Pool
Watson - Contr.
 Spudding Date 3-22-55

Drlg. Data Oil well TD 2962
8" @ 90 KC 2335 Oswego 2654
Bart. 2938 TD 2962 5" @ 2939
CO to 2962 PB 2960 frac
Comp. 25 bopd

FABEN GILSTRAP