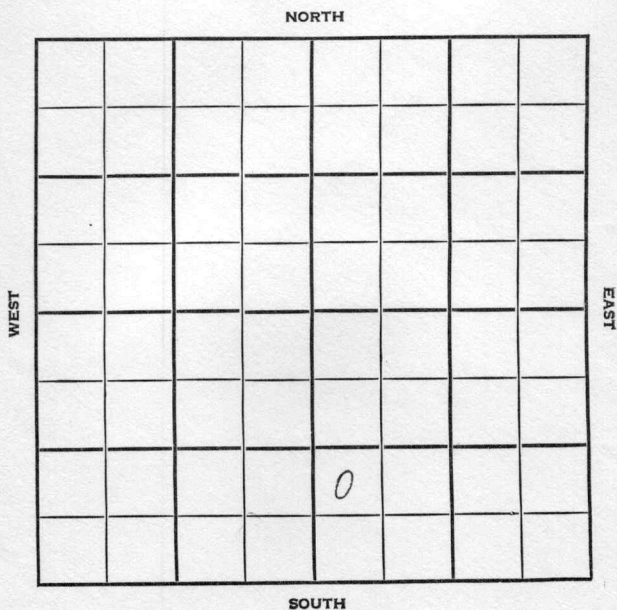


Section 10 Township 31 Range 4 EWell No. #7 HustonCompany McNeish & Gralapp

Cowley

KANSAS

SEC.	10	TWP.	31	R.	4E
------	----	------	----	----	----

WELL NO.

#7 Huston

FARM

COMPANY

McNeish & Gralapp

CONTRACTOR


~~James~~ Watson
David

Ft. from N. Line

Ft. from S. Line

Ft. from E. Line

Ft. from W. Line

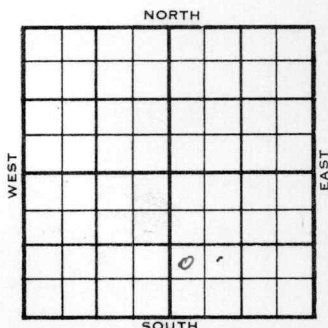

NW SW SE

1955

ELEVATION

1265'

REPORT

8/24

Location

9-21

Comm. 8-22-55
 8 5/8" @ 90 w/75
 5 1/2" @ 2953;
 CO 2975; frac;
 Pmp 25 bopd no wtr.
 Tops Depth Log
 Stall 1950
 K.C. 2358
 Clev. 2652
 Oswego 2668
 Barts. 2951 2952
 T.D. 2975'

COMPLETED

County Cowley Elev. _____Sec. 10 Twp. 31 Rge. 1ECompany McNeish & GralappFarm Name Huston No. 7

TOPS

DEPTH

LOG

DATUM

Loc. in Sec. _____

Anh.

Tp.

H.

Tr.

Dg.

B.L.

L.

K.C.

B.K.C.

Ce.

C.

M.

M.

K.

Mz.

Mq.

V.

S.

S.

A.

R.

P.E.

G.

T.D.

NW SW SE

Geol. _____

Contr. _____

Watson

Pool _____

David

AUG 24 '55

FIRST REPORT

Date Comm. _____

Location _____

Co.

Lse.

No.

Sec.

T.

R.

County **Cowley** Elev. **1265** Co. **10**
 Sec. **10** Twp. **31S** Rge. **4E**
 Company **McNeish & Gralapp**
 Farm Name **Huston** No. **7**

TOPS	DEPTH	LOG	DATUM	Loc. in Sec.
Anh.				NW SW SE
Tr.				
Dg.				
Stall		1950	685	
B.L.				
L.				
K.C.		2358	1093	Geol.
Clve.		2652	1387	Contr.
Oswego		2658	1103	
C. Barts.	2951	2952	1687	Watson
M.				
M.				
K.				Pool
Mz.				David
Mq.				
V.				
S.				
S.				
A.				
R.				
Pf.				
G.				
T.D.	2975	2977		

Date Comm. **8-22-55** SEP 21 1955

8-5/8" 90 w/75; 5 1/2" 2953; CO 2975; frac;
Pmp 25 bopd no wtr.