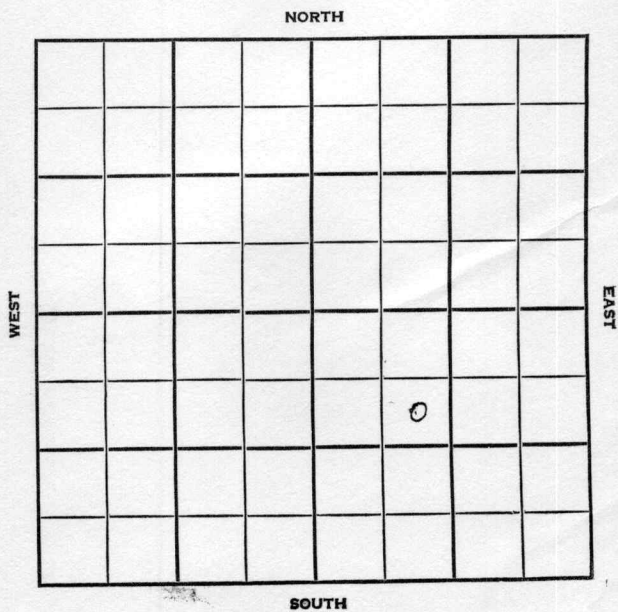


Section 10 Township 31S Range 1EWell No. #8 HustonCompany McNsish & Gralapp

Cowley

KANSAS

SEC.	TWP.	R.
10	31	4E

WELL NO.

#8 Huston

FARM

COMPANY

McNeish & Gralapp

CONTRACTOR

Watson

David


Ft. from N. Line

Ft. from S. Line

Ft. from E. Line

Ft. from W. Line

SE NW SE

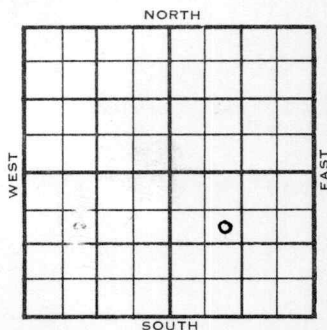

1955

ELEVATION

1260'

REPORT

8/31

Location

9-21

Comm. 8-31-55

8 5/8" @ 91 w/70

5 1/2" @ 2949

CO 2970;

frac;

Pmp 25 bopd no wtr.

Tops

Log

Stall

1933

K.C.

2348

Clev.

2604

Oswego

2662

Barts

2948

T.D. 2970'

COMPLETED

County Cowley Elev. _____
Sec. 10 Twp. 31 Rge. 4E
Company McNeish & Gralapp
FarmName Huston No. 8

TOPS	DEPTH	LOG	DATUM
Anh.			
TP.			
H.			
Tr.			
Dg.			
BL.			
L.			
K.C.			
B.K.C.			
Ce.			
C.			
M.			
M.			
K.			
Mz.			
Mq.			
V.			
S.			
S.			
A.			
R.			
PE.			
G.			
T.D.			

Loc. in Sec. SE NW SE

Geol. _____

Contr. Watson

Pool David

	AUG 31 '55	

FIRST REPORT

Date Comm. _____

Location _____

Co. _____

Lse. _____

No. _____

Sec. _____

T. _____

R. _____

County **Cowley** Elev. **1260**
 Sec. **10** Twp. **31S** Rge. **4E**
 Company **McNeish & Gralapp**
 Farm Name **Huston** No. **8**

TOPS	DEPTH	LOG	DATUM	Loc. in Sec.
Anh. Stall		1933	673	SE NW SE
Tp.				
H.				
Tr.				
Dg.				
B.L.				
L.				
K.C.		2348	1088	Geol. _____
B.K.C. Clev.		2604	1344	Contr. _____
Ce. Oswego		2662	1402	
C. Barts.		2948	1688	Watson
M.				
M.				Pool
K.				David
Mz.				
Mq.				
V.				
S.				
S.				
A.				
R.				
Pe.				
G.				
T.D.	2970			

SEP 21 1955

Date Comm. **8-31-55**

8-5/8" 91 w/70; 5 1/2" 2949; CO 2970;
frac; pmp 25 bopd no wtr.