


DX 78-1

Section 10 Township 31 Range 1E

Well No. 3 O'Hara "A"

Company McNeish & Gralapp

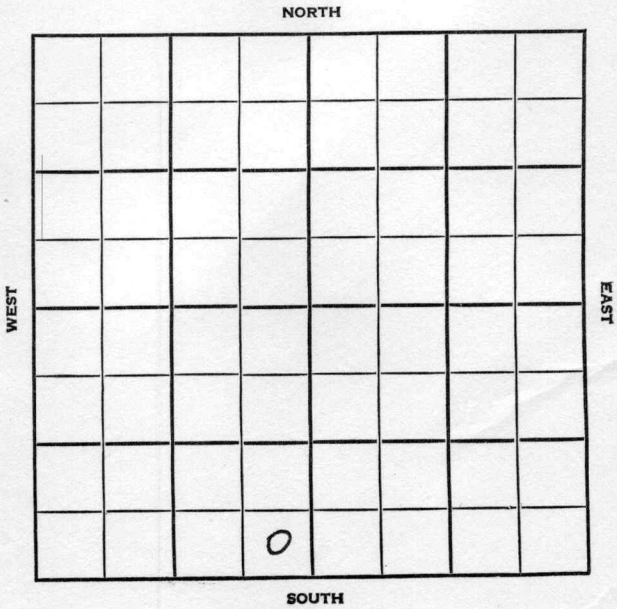

Cowley KANSAS

SEC.	TWP.	R.
10	31	4E

WELL NO. **3 O'Hara "A"** FARM

COMPANY **McNeish & Gralapp**

CONTRACTOR **Watson**

**David Pool**


\_\_\_\_\_ Ft. from N. Line

**330** \_\_\_\_\_ Ft. from S. Line

**330** \_\_\_\_\_ Ft. from E. Line

\_\_\_\_\_ Ft. from W. Line

SE SE SW

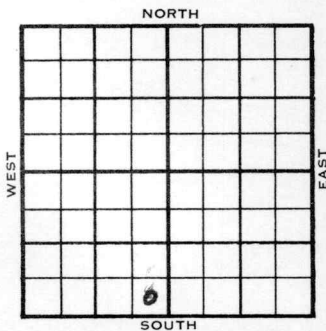

1954	ELEVATION 1261	REPORT
------	-------------------	--------

7/14 Spud 7-8-54  
8" @ 90'  
Drlg. 1935'

8-18 Spdg 7-8-54  
Oil well  
TD 2986  
8" @ 90  
Stal 1940 KC 2367 Oswego 2678  
Bart. 2959  
TD 2986  
5" @ 2961 CO to 2986 PB 2980  
frac S & F/20 boph Comp. 25 bopd

**COMPLETED**



