


Section 10 Township 31 Range 4 E

Well No. # 4 O'Hara "A"

Company McNeish & Gralapp

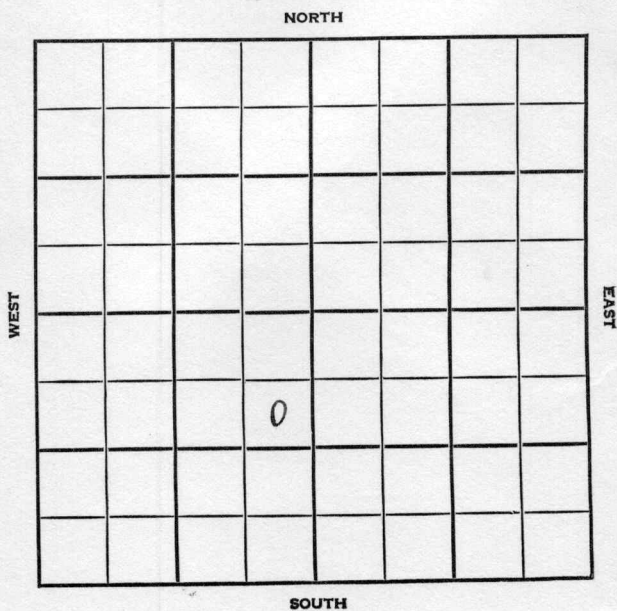

Cowley

KALWIND

SEC.	TWP.	R.
10	31	4E


WELL NO. #4 O'Hara "A" FARM

COMPANY McNeish & Gralapp

CONTRACTOR Watson Drlg.

NW David Pool

990 _____ Ft. from N. Line
 _____ Ft. from S. Line
 330 _____ Ft. from E. Line
 _____ Ft. from W. Line

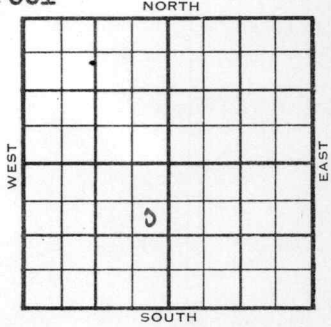

SE NE SW

1954	ELEVATION 1236'	REPORT
------	--------------------	--------

12/22 MIR

1955
1/26

Spud 12-27-54
 Oil well TD 2948 8" @ 90
 KC 2330 Oswego 2642 Bart. 2931
 TD 2948 5" @ 2932 CO to 2948
 frac. F/38 BOPH Comp. 25 BOPD

COMPLETED

