


Section 7 Township 31 Range 4 E

Well No. #2 DeWitt

Company Stelbar Oil

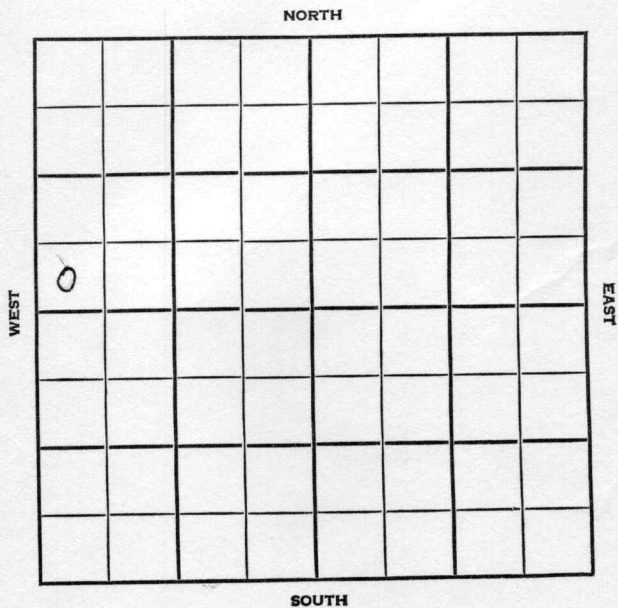

Cowley

KANSAS


SEC.	7	TWP.	31	R.	4E
------	---	------	----	----	----

WELL NO. #2 DeWitt FARM

COMPANY Stelbar Oil

CONTRACTOR

_____ Ft. from N. Line
 300 _____ Ft. from S. Line
 _____ Ft. from E. Line
 200 _____ Ft. from W. Line

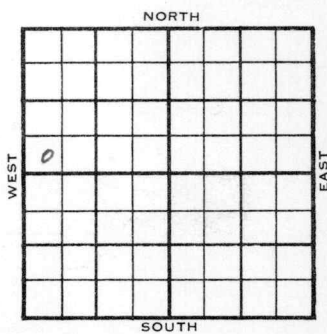

SW SW NW

1955	ELEVATION 1146'	REPORT
------	--------------------	--------

10/5 Loc

11/9 Comm 10-10-55
 Bart 2866
 TD 2902
 CO 39/2869-82 frac
 Comp 25 bopd

COMPLETED

