


Section 7 Township 31 Range 4E
Well No. 6 Graham
Company Stelbar Oil

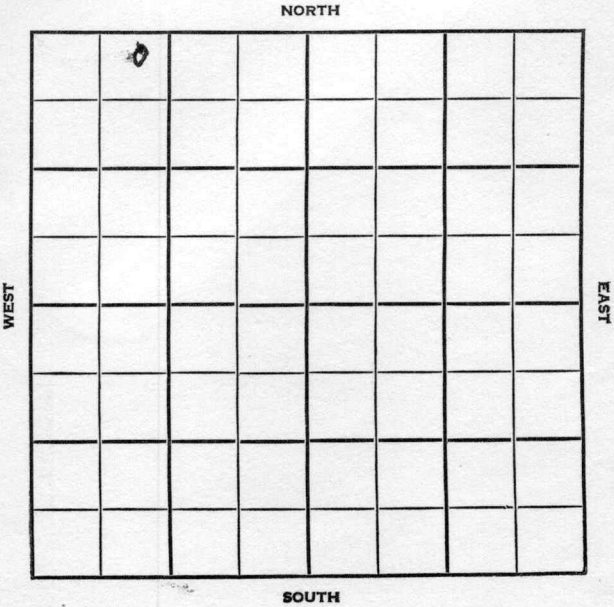

Cowley

KANSAS

SEC.	7	TWP.	31	R.	4E
------	---	------	----	----	----

WELL NO.

#6 Graham

FARM

COMPANY

Stelbar Oil

CONTRACTOR

Ca Tools.

Clark Pool

100


Ft. from N. Line

Ft. from S. Line

Ft. from E. Line

750

Ft. from W. Line

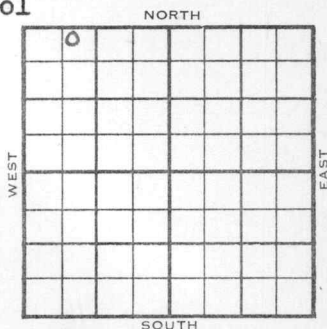

NE NW NW

ELEVATION

REPORT

1955

4/20

MIR

6/15

Comm 4-19-55

8 5/8", @42/50, 5 1/2" @ 2868/75

CO to TD frac S/30 boph Comp. 35 bopd

H. Bart

2868

1716

TD.

2888

COMPLETED

County Cowley State KansasSec. 7 (Blk.) 31 (Sur. Rge.) 4E Map No. _____Operator Stelbar OilWell No. 6 Farm GrahamElev. _____ Location NE NW NW

0							

FIRST REPORT

100 Ft. From N Line NW750 Ft. From W Line Quarter1st. Report APR 20 1955

Completion _____

Remarks _____

Co. tools

Spudding Date _____

Drlg. Data Clark PoolM I R

FABEN GILSTRAP

County Cowley ✓ Elev. 1152
 Sec. 7 Twp. 31 Rge. 4E
 Company Stelbar Oil
 Farm Name Graham No. 6

TOPS	DEPTH	LOG	DATUM	Loc. in Sec.
Anh.				NE NW NW
Tr.				
H. <u>Bart</u>	<u>2868</u>		<u>1716</u>	100' NL
Dg.				750' WL
Bl.				
L.				Geol.
K.C.				Contr.
B.K.C.				
Ce.				
C.				
M.				Pool
M.				Clark
K.				
Mz.				
Me.				
V.				
S.				
S.				
A.				
R.				
Pe.				
G.				
TD.	<u>2888</u>			

0

COMPLETE

Date Comm. 4-19-55 JUN 15 1955

8 5/8" @ 42/50 5 1/2" @ 2868/75

CO to TD frac S/ 30 boph

Comp. 35 bopd