

Cowley


KANSAS

DX 78-1

Section 10 Township 31 Range 1E

Well No. #2 O'Hara "B"

Company McNeish & Gralapp

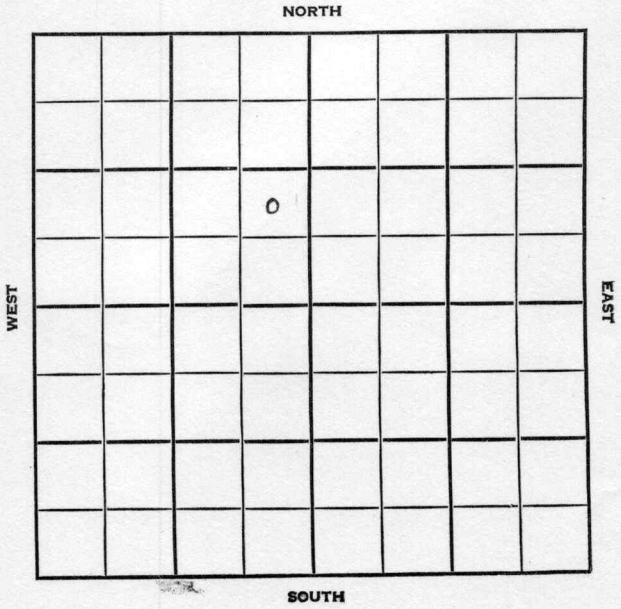

Cowley

KANSAS

SEC.	TWP.	R.
10	31	1E ✓

WELL NO. #2 O'Hara "B" FARM

COMPANY

CONTRACTOR **McNeish & Gralapp**


Watson Drlg.

David Pool
Ft. from N. Line

990 Ft. from S. Line

330 Ft. from E. Line

Ft. from W. Line

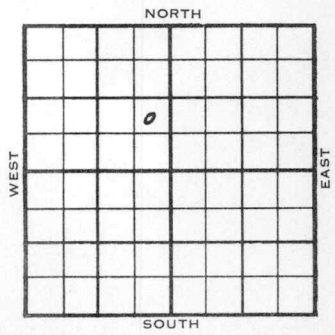

NE SE NW

	ELEVATION	REPORT
1954	1245	

5/19	8" @ 85'	
6/23	Spudding 6-8-54 D & A TD 2977 8" @ 85 Stal. 1920 KC 2330 Miss. 2960 TD 2977 D & A	

ABANDONED

County **Cowley** State **Kansas**

Sec. **10** (Blk. **31**) (Sur. Rge.) **4E** Map No.

Operator **McNeish & Gralapp**

Well No. **2** Farm **O'Hara "B"**

Elev. Location **NE SE NW**

990 Ft. From **S** Line **NW**

330 Ft. From **E** Line Quarter

1st. Report **MAY 19 1954**

Completion

Remarks

Watson D_rlg. - Contr.

Spudding Date

Drlg. Data **David Pool**

8" @ 85

