

Cowley

KANSAS


DX 78-1

Section 10 Township 31 Range 4 E

Well No. #5 O'Hara "A"

Company McNeish & Gralapp

NORTH

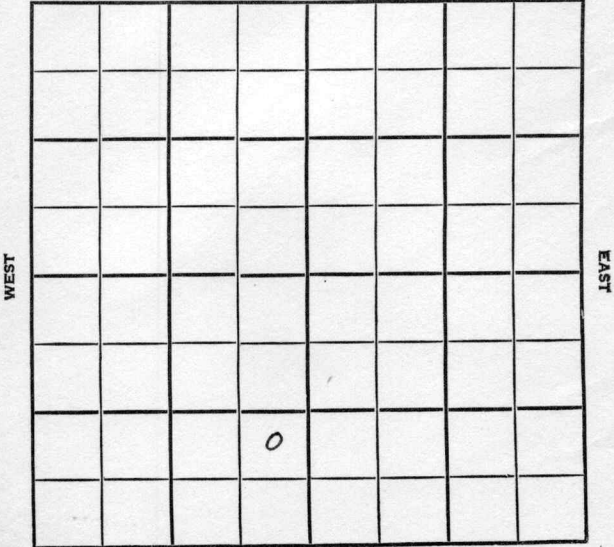

SOUTH

Cowley

KANSAS

SEC.	TWP.	R.
10	31	4E

WELL NO. #5 O'Hara "A" FARM

COMPANY McNeish & Gralapp

CONTRACTOR Watson Drlg.


David

_____ Ft. from N. Line

_____ Ft. from S. Line

_____ Ft. from E. Line

_____ Ft. from W. Line

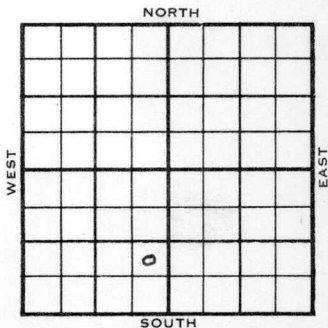

NE SE SW

1955	ELEVATION	REPORT
------	-----------	--------

8/17

R U R

9/7

Comm 8-15-55
 H Stal 1920
 KC 2341
 BKC Clove 2607
 Ce Oswego 2655
 C Bart 2938
 8 5/8" @ 96/75 5 1/2" @ 2939 CO
 to 2962 PB 2960 frac
 Comp 25 bopd

COMPLETED

County Cowley Elev. _____
 Sec. 10 Twp. 31 Rge. 4E
 Company McNeish & Gralapp
 Farm Name O'Hara "A" No. 5

Co.

TOPS	DEPTH	LOG	DATUM
Anh.			
TP.			
H.			
Tr.			
Dg.			
Bl.			
L.			
K.C.			
B.K.C.			
Ce.			
C.			
M.			
M.			
K.			
Mz.			
Ma.			
V.			
S.			
S.			
A.			
R.			
PE.			
G.			
T.D.			

Loc. in Sec. NE SE SW
 Geol. _____
 Contr. Watson Drlg
 Pool David

Use

FIRST REPORT

AUG 17 1955

No.

Date Comm. RUR

Sec.

T.

R.

County Cowley Elev. _____
 Sec. 10 Twp. 31 Rgs. 1E
 Company McNeish & Gralapp
 Farm Name O'Hara "A" No. 5

TOPS	DEPTH	LOG	DATUM	Loc. in Sec.
Anh.				NE SE SW
Tp.				
H. <u>Hal</u>		<u>1920</u>		
Tr.				
Dg.				Geol. _____
Bl.				
L.				Contr. _____
K.C.		<u>2341</u>		
B.K.C. <u>Clerge</u>		<u>2607</u>		Watson
Ce. <u>Bowen</u>		<u>2657</u>		
C. <u>Bark</u>		<u>2938</u>		Pool _____
M.				
M.				David
K.				<div style="border: 1px dashed black; padding: 10px; text-align: center;"> <p>COMPLETE</p> </div>
Mz.				
Mq.				
V.				
S.				
S.				
A.				
R.				
Pf.				
G.				
T.D.				

Date Comm. 8-15-55 **SEP 7 1955**
8 5/8" @ 96/75 5 1/2" @ 2939 CO to 2962

PB 2960 frac Comp. 25 bopd

Co.
Lse.
No.
Sec.
T.
R.