


Section 10 Township 31 Range 4 E

Well No. # 3 Watt

Company Texas Company

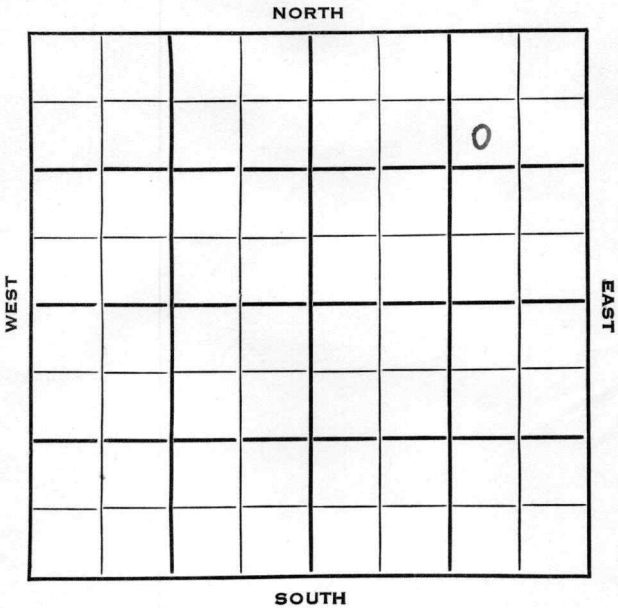

Cowley

KANSAS

|      |      |      |
|------|------|------|
| SEC. | TWP. | R.   |
| 10   | 31   | 4E ✓ |

WELL NO.

#3 Watt

FARM

COMPANY

Texas Company

CONTRACTOR

Wakefield

NW David Pool

990

Ft. from N. Line


Ft. from S. Line

990

Ft. from E. Line

Ft. from W. Line

SW NE NE

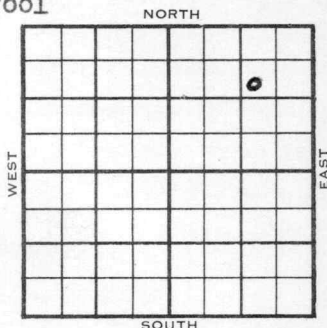

1953

ELEVATION

1263'

REPORT

11/24

Cellar &amp; Pits.

12/22

Spud 11-28-53

Oil Well

TD2998'

10" @ 152'

KC 2340',

DST 2334'-46' opn 1 hr, rec 20' Mud

TD 2998'

Schlumberger Tops: Stal. 1937', KC 2330' B KC 2558', Marm 2654', Check-board 2771', Bart 2934', Miss 2986', 7" @ 2997'

CO to 2965'

19/ 2948-54 S/ 40 go 14 gw 2 hr.

200 A sd-frac F 132 bo 8 hr.

Comp 25 bopd.

COMPLETED



County Cowley State Kansas  
 Sec. 10 (Blk.) 31 (Sur.) 4E Map No.

Operator Texas Company

Well No. 3 Farm Watt

Elev. 1263 Location SW NE NE

|  |  |  |  |  |  |
|--|--|--|--|--|--|
|  |  |  |  |  |  |
|  |  |  |  |  |  |
990 Ft. From N Line NE

990 Ft. From E Line Quarter

1st. Report

Completion DEC 22 1953

Remarks NW David Pool

Wakefield - Contr.

Spudding Date 11-28-53

Drlg. Data Oil well TD 2998

10" @ 152 KC 2340 DST 2334-46

open 1 hr. Rec. 20' mud TD 2998

SCHLUMBERGER TOPS

Stal. 1937 KC 2330 B KC 2558

Marm. 2654 Checkerboard 2771 Bart. 2934

Miss. 2986 7" @ 2997 CO to 2965

19/ 2948-54 S/ 40 go 14 gw 2 hr.

200 A sd-frac F/ 132 bo 8 hr.

Comp.. 25 bopd

J. G. McGEHEE