

KANSAS

Barton


Section 7 Township 20 Range 12W

Well No. 4 Schartz

Company Hanlon & Boyle

Sunny Valley

NORTH

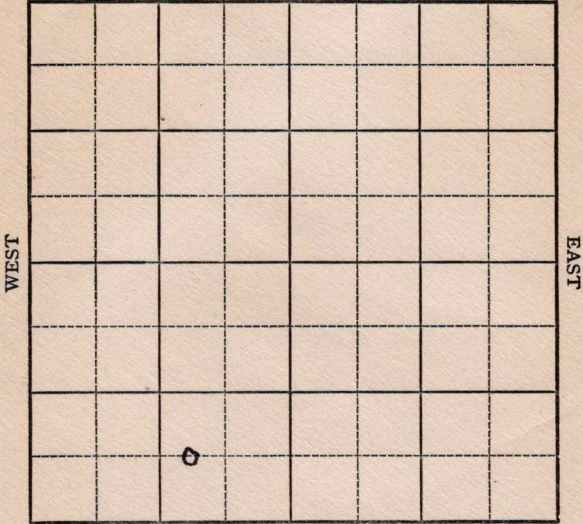

SOUTH

KANSAS

Barton

✓
12W

Sec. 7 Twp. 20 R. 12W

Well No. #4 Schartz (A) Farm

Hanlon & Boyle Company

Sunny Valley


_____ Ft. from N. Line

660' Ft. from S. Line

330'
990' Ft. from E. Line

_____ Ft. from W. Line

W
C E L SE SW

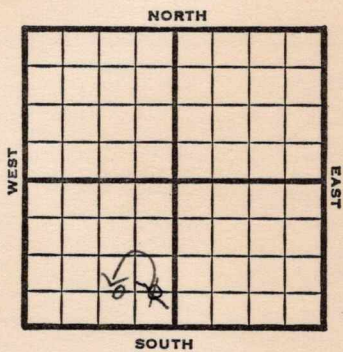

1949

Elev 1844' REPORT

- 3/9 RUR
- 3/16 8"@ 370
Drlg 2205'
- 3/22 **Lansing 3156'**
Drlg 3325'
- 3/30 **Arb. 3453-55'**
TD 3455'
5"@ 3454'
48 shots 3190-96'
48 shots 3178-84'
"
- 4/6 TD 3455'
- 4/13 **Arb 3453'**
Lans. 3156'
5"@ 3454'
Perf Lans.
Bomb Pot 3000 Oil
39° Gr.
Comp

COMPLETED

Map No. _____ Sec. 7 Twp. 20 R. 12W

Well No. 4 Schartz

Hanlon & Boyle Company

FIRST REPORT Contractor

C E L S E S W

SECTION PLAT

_____ Ft. from N. Line

660 Ft. from S. Line

330 Ft. from E. Line

_____ Ft. from W. Line

Barton County

RECORD

Location _____

Cased _____ in., _____ ft.

Rig up _____

Sand _____

Drilling and Remarks:

Gas _____

Oil _____

Total Depth _____

R U R

PRODUCTION

1st 24 hrs. Nat. _____

1st 24 hrs. after shot _____

Gas _____ Cu. Ft.

Dry Hole _____

Abandoned _____

Date

MAR 9 1949

S. J. LEWIS Scout

Map No. _____ Sec. 7 Twp. 20 R. 12W

Well No. 4 Scharzt

Hanlon & Boyle Company

CORRECTION Contractor

C W L SE SW

SECTION PLAT

_____ Ft. from N. Line

660 Ft. from S. Line

990 Ft. from E. Line

_____ Ft. from W. Line

Barton County

Location _____

Rig up _____

Drilling and Remarks:

Reported

C E L SE SW

RECORD

Cased _____ in., _____ ft.

Sand _____

Gas _____

Oil _____

Total Depth _____

PRODUCTION

1st 24 hrs. Nat. _____

1st 24 hrs. after shot _____

Gas _____ Cu. Ft.

Dry Hole _____

Abandoned _____

Date

MAR 9 1949

19

S. J. LEWIS

Scout

Kansas

Map No. 46 Sec. 7 Twp. 20 R. 12W

Well No. 4 Scharzt

Hanlon & Boyle Company

COMPLETE

Contractor

C W L SE SW

E1,1844
SECTION PLAT

_____ Ft. from N. Line

660 Ft. from S. Line

990 Ft. from E. Line

_____ Ft. from W. Line

	0		

Barton County

Location _____

Rig up _____

Drilling and Remarks:

Cost 3453
Lans 356
5" 3454
Prof Lans
Some 200000
89 = 82

RECORD

Cased _____ in., _____ ft.

Sand _____

Gas _____

Oil _____

Total Depth 3455

PRODUCTION

1st 24 hrs. Nat. _____

1st 24 hrs. after shot _____

Gas _____ Cu. Ft.

Dry Hole _____

Abandoned _____

Date

APR 13 1949 19

S. J. LEWIS

Scout