


Section 7 Township 20 Range 12W

Well No. 2 Schartz

Company Hanln & Boyle

No name
NORTH

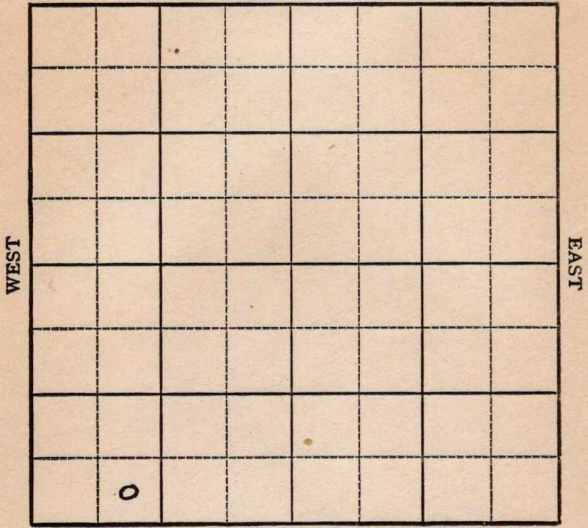

SOUTH

Sec. 7 Twp. 20 R. 12W

Well No. #2 Schartz Farm
Hanlon & Boyle Company


No name

_____ Ft. from N. Line

330' Ft. from S. Line

_____ Ft. from E. Line

990' Ft. from W. Line

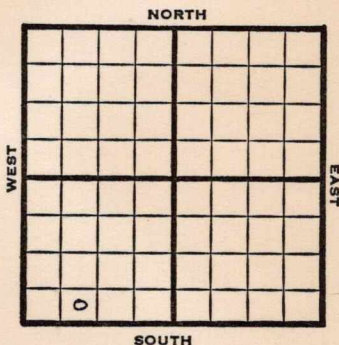

SE SW SW

1949

Elev 1865' REPORT

1/19
1/26

Surface Hole
8" @ 364'
Drlg 2335'

2/2

Lansing 3182'
Drlg. 3240'

2/9

Arbuckle 3432'
TD 3435'
5" @ 3433'

/2/16

40 shots to 3231-26
No shows
72 shots 3209-17
Flow

2/23

TD 3435'
Arb. 3432'
Lans. 3182'
5" @ 3433'
Perf Lans.
Depth Pot 3000 Oil
42° Gr.
Comp

COMPLETED

Map No. _____ Sec. 7 Twp. 20 R. 12W

Well No. 2 Scharitz

Hanln & Boyle Company

FIRST REPORT Contractor

SE SW SW

SECTION PLAT

_____ Ft. from N. Line

330 Ft. from S. Line

_____ Ft. from E. Line

990 Ft. from W. Line

Barton County

Location _____

Rig up _____

Drilling and Remarks:

surface hole

RECORD

Cased _____ in., _____ ft.

Sand _____

Gas _____

Oil _____

Total Depth _____

PRODUCTION

1st 24 hrs. Nat. _____

1st 24 hrs. after shot _____

Gas _____ Cu. Ft.

Dry Hole _____

Abandoned _____

Date

JAN 1 9 1949 19

S. J. LEWIS Scout

Kansas

Map No. K-46 Sec. 7 Twp. 20 R. 12W

Well No. 2 Schartz

Hanlon & Boyle Company

COMPLETE Contractor

SE SW SW

E. 1865

SECTION PLAT

_____ Ft. from N. Line

330 Ft. from S. Line

_____ Ft. from E. Line

990 Ft. from W. Line

Barton County

Location _____

Rig up _____

Drilling and Remarks:

Core X 3482
4 am 3182
5" @ 3433
Prof Hans.
Depth 3000 ft
42 2/3

RECORD

Cased _____ in., _____ ft.

Sand _____

Gas _____

Oil _____

Total Depth 3435

PRODUCTION

1st 24 hrs. Nat. _____

1st 24 hrs. after shot _____

Gas _____ Cu. Ft.

Dry Hole _____

Abandoned _____

Date

FEB 23 1949 19

S. J. LEWIS Scout