

Section 8 Township 20 Range 12WWell No. #1 LantermanCompany Hexagon Oil & Franco Central

NORTH

							0

WEST

EAST

SOUTH

Barton

KANSAS

Sec. 8 Twp. 20 R. 12 W

Well No. # 1 Lanterman Farm

Hexagon Oil & Franco Central Company

Contractor

Wildcat


Ft. from N. Line

330 Ft. from S. Line

330 Ft. from E. Line

Ft. from W. Line

SE SE NE

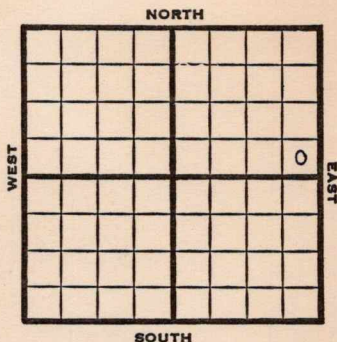

1951

Elev. 1831' REPORT

5/2

Spud 4-29-51
8" @ 221
Drilg. 1950'

5/9

Spud 4-29-51
D&A TD 3455
8" @ 221
Heeb. 3036'
Br Lime 3152 Lans. 3167
DST 3170-3235 opn $\frac{1}{2}$ hr
Rec. 30' mud
DST 3298-3310 opn $\frac{1}{2}$ hr
Rec. 60' mud & SSO
Cong. 3408
Arb. 3423
DST 3424-30 opn 1 hr
Rec. 4' mud DST 3426-55 TD
opn 1 hr Rec. 20' socm 50' mud & sw
D&A

ABANDONED

County Barton State Kansas
 Sec. 8 (Blk.) 20 (Sur.) 12W Map No.
 (Twp.) (Rge.)

Operator Hexagon Oil & Franco Central

Well No. 1 Farm Lanterman

Elev. Location SE SE NE



330 Ft. From S Line NE

330 Ft. From E Line Quarter

1st. Report MAY 2 1951

Completion


Remarks

Spudding Date 4-29-51

Drlg. Data Wildcat

8" @ 221 drlg. 1950

J. E. TYRA

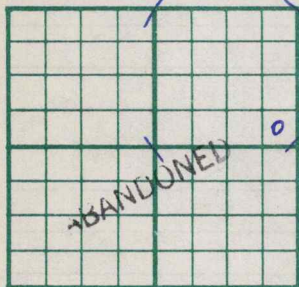County Barton State KansasSec. 8 (Blk.
Twp.) 20 (Sur.
Rge.) 12W Map No.Operator Hexagon Oil & Franco CentralWell No. 1 Farm LantermanElev. 1831 Location SE SE NE330 Ft. From S Line NE330 Ft. From E Line Quarter1st. ReportCompletion MAY 9 1951Remarks WildcatSpudding Date 4-29-51Drlg. Data D & A TD 34558" @ 221 Heeb, 3036 Br. lime 3152Lans. 3167 DST 3170-3235 open $\frac{1}{2}$ hr.Rec. 30' mud, DST 3298-3310 open $\frac{1}{2}$ hr.Rec. 60' mud & SSO Cong. 3408Arb. 3423 DST 3424-30 open 1 hr.Rec. 4' mud DST 3426-55 TD open 1 hr.Rec. 20' socm 50' mud & swD & A

J. E. TYRA