


Section 10 Township 31S Range 4E

Well No. #16 Watt

Company The Texas Co.

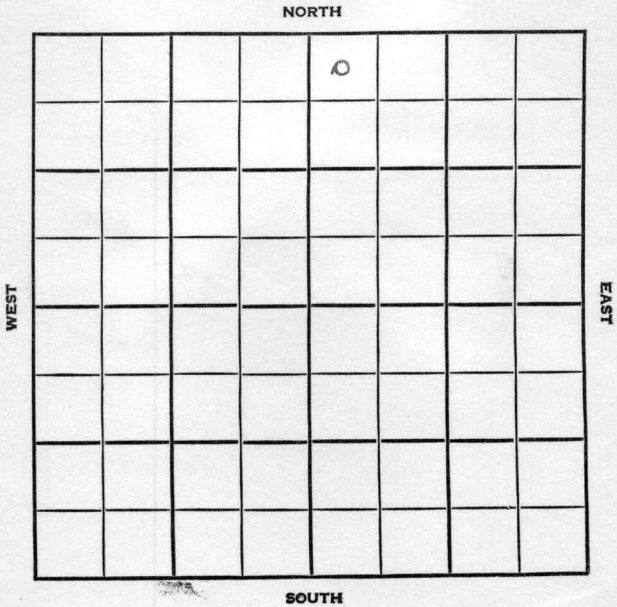

Cowley KANSAS

SEC.	TWP.	R.
10	31S	4E

WELL NO.

16 Watt

FARM

COMPANY

The TexasCo.

CONTRACTOR

Wakefield Tools


David

330 Ft. from N. Line

Ft. from S. Line

Ft. from E. Line

330 Ft. from W. Line

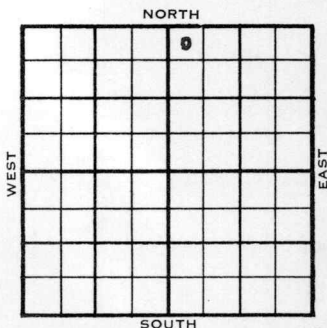

NW NW NE

1954	ELEVATION 1227'	REPORT
------	--------------------	--------

12/8 Spdg.

12/22 Spud 12-6-54 D & A TD 2965
 10" @ 105 KC 2308 B KC 2526
 Marm. 2621 Cherokee 2753 Miss 2953
 TD 2965 D & A

ABANDONED

County Cowley State Kansas
 (Blk.) (Sur.)
 Sec. 10 (Twp.) 31S Map No. 4E
 Operator The Texas Co.
 Well No. 16 Farm Watt
 Elev. _____ Location NW NW NE

Ft. From 330 N Line
 Ft. From 330 W Line NE Quarter
 1st. Report DEC 8 1954

Completion _____

Remarks Wakefield tools

Spudding Date _____

Drlg. Data _____

David

Spdg

FABEN GILSTRAP

County Cowley State KansasSec. 10 (Blk. 31 (Sur. 4E Map No.Operator Texas CompanyWell No. 16 Farm WattElev. 1227 Location NW NW NE

330 Ft. From N Line NE330 Ft. From W Line Quarter

1st. Report

Completion DEC 22 1954Remarks David PoolWakefield - Contr.Spudding Date 12-6-54Drlg. Data D & A TD 296510" @ 105 KC 2308 B KC 2526Marm. 2621 Cherokee 2753 Miss. 2953TD 2965D & A

FABEN GILSTRAP