


Section 11 Township 31 Range 4E

Well No. #4 Carper - Richards

Company E. R. Wakefield & CRA

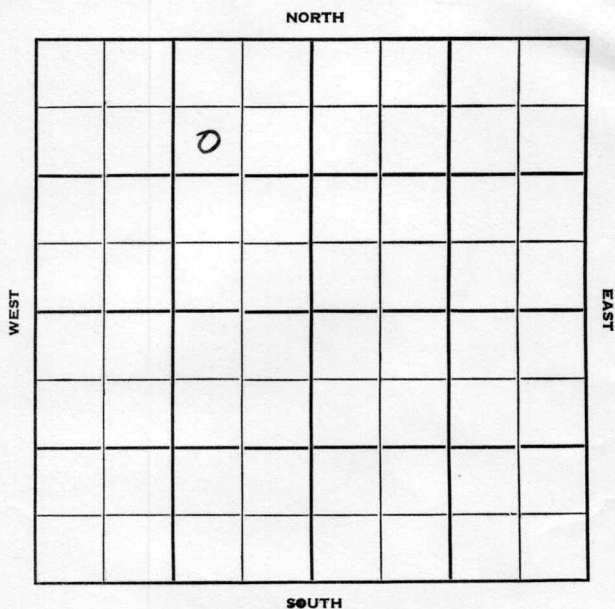

Cowley

Sec. 11 Twp. 31 R. 4E

Well No. #4 Carper-Richards Farm

E. F. Wakefield & CRA Company

Wakefield - Contr. Contractor

S. David Pool


990' Ft. from N. Line

Ft. from S. Line

990' Ft. from E. Line

Ft. from W. Line

SW NE NW

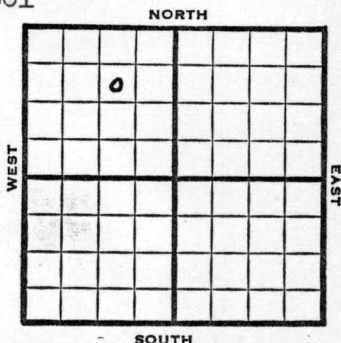

1952

Elev. 1287

REPORT

7/9

Spud 7-5-52

8" @ 83'

Drlg. 1560

8/13

Spud 7-5-52

Oil Well TD 3005

8" @ 83 Bart 2990

5" @ 2990

TD 3005 4 to 5 boph Hydro

S/7 boph Comp. 21 bopd

COMPLETED

County Cowley State Kansas

Sec. 11 (Blk. Twp.) 31 (Sur. Rge.) 4E Map No.

Operator E. F. Wakefield & CRA

Well No. 4 Farm Carper - Richards

Elev.	Location	SW	NE	NW
-------	----------	----	----	----

0

FIRST REPORT

990 Ft. From N Line NW

990 Ft. From E Line Quarter

1st. Report JUL 9 1952

Completion _____

Remarks

Wakefield - Contr.

Spudding Date 7-5-52

Drig. Data S. David Pool

8" @ 83 d rlg. 1560

Sec. 11 (Blk. Twp.) 31 (Sur. Rge.) 4E Map No.

Well No. 4 Farm Carper - Richards

990Ft. From E Line Quarter

Completion **AUG 13 1952**

Wakefield - Contr.

Spudding Date 7-5-52

Drilg. Data Oil well TD 3005

8" @ 83 Bart. 2990 5" @ 2990

TD 3005 4 to 5 goph Hydro. S/ 7 boph

Comp. 21 bopd

J. G. McGEHEE