


Barton

KANSAS

SECTION 8 TOWNSHIP 20S RANGE 12W

WELL NO. #1 Tonkins

COMPANY B.E. Ash

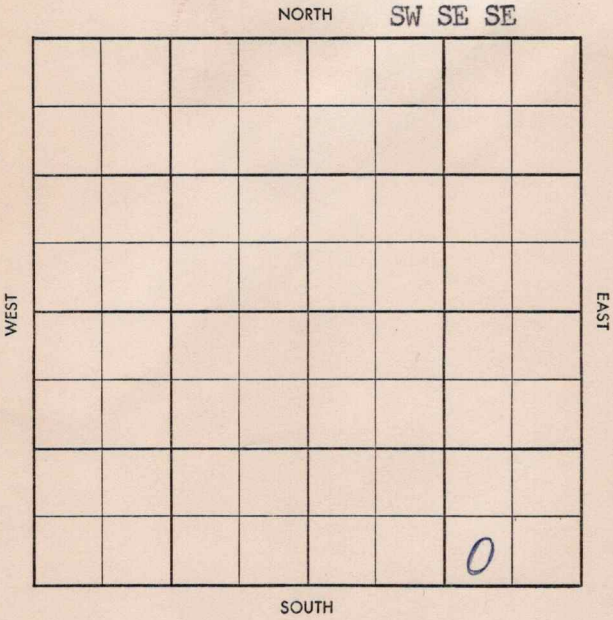

SEWING

13

S-513-B

County Barton Elev. _____
 Sec. 8 Twp. 20 Rge. 12W
 Company B. E. Ash
 Farm Name Tonkins No. 1

TOPS	DEPTH	LOG	DATUM
Anh.			
Tp.			
H.			
Tr.			
Dg.			
B.L.			
L.			
K.C.			
B.K.C.			
Ce.			
C.			
M.			
M.			
K.			
Mz.			
Mq.			
V.			
S.			
S.			
A.			
R.			
Pf.			
G.			
T.D.			

Loc. in Sec. SW SE SE
 Geol. _____
 Contr. Bea Drlg.
 Pool _____
 Workman No. _____

FIRST REPORT
 JAN 22 '58

Date Comm. _____
 Location Location

Co.
Lse.
No.
Sec.
T.
R.

Twp. 20 Pool 12W
 Co. Barton Facet 1

5-513-B

County Barton Elev. 18440 184768
 Sec. 8 Twp. 20 Rge. 12W
 Company B. E. Ash
 Farm Name Tonkins No. 1

TOPS	DEPTH	LOG	DATUM
Anh.	<u>646</u>		
Tp.			
H.	<u>3042</u>		
Tr.			
Dg.			
B.L.	<u>3158</u>		
L.	<u>3176</u>		
K.C.			
B.K.C.			
Ce.			
C.			
M.			
M.			
K.			
Mz.			
Mq.			
V.			
S.			
S.			
A.	<u>3428</u>		
R.			
Pf.			
G.			
T.D.	<u>3475</u>		

Loc. in Sec. SW SE SE
 Geol. _____
 Contr. Bea Drlg.
Sunnyvalley NE
 Pool _____
 Workman No. _____

COMPLETE
 AUG 27 '58

Date Comm. 1-30-58 8"228
 Location JAN 29 '58 FEB 5 '58 Ø 2069 FEB 12 '59
DST 3194-3246 60" 25' M BHP
Ø DST 3300-20 60" 25' M BHP
250 DST 3428-45 60" 30' ORN
BHP 1020 FEB 19 '58 DST 3445-57
60" 10' 0" / 28" M BHP 730
5" 3474 FEB 26 '58 MAR 5 '58 20 32/3438
- 46 (1/2) all w PB 3442 (1/2) 24-3
BØ + 28 Wph T&R MAR 12 '59 MAR 19 '59
MAR 26 '58 APR 2 '58 pumping APR 9 '58

APR 16 '58

D 11-12 BO ~~ph~~ 70% W

APR 23 '58 APR 30 '58 MAY 7 '58 MAY 14 '58 MAY 21 '58 MAY 28 '58

JUN 3 '58 JUN 11 '58 JUN 18 '58 JUN 25 '58 JUL 2 '58

torawork JUL 9 '58 JUL 16 '58 Pumping

JUL 23 '58 JUL 30 '58 AUG 6 '58

P 12 BO + 70% W

AUG 13 '58 AUG 20 '58 AUG 27 '58

P 12 BO + 75% WTR

38°

ARB.

8-20-12W

SWSESE