


Section 12 Township 27 Range 8-E

Well No. #2 Baldwin "A"

Company K. T. Wiedemann

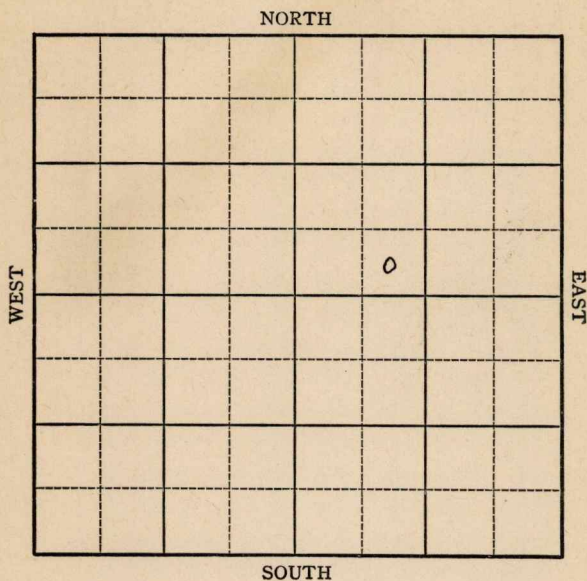

KANSAS

Greenwood

Sec. 12 Twp. 27 R. 8-E

Well No. #2 Baldwin "A" Farm

K. T. Wiedemann Company


Miscellaneous

 Ft. from N. Line

330 Ft. from S. Line

 Ft. from E. Line

990 Ft. from W. Line

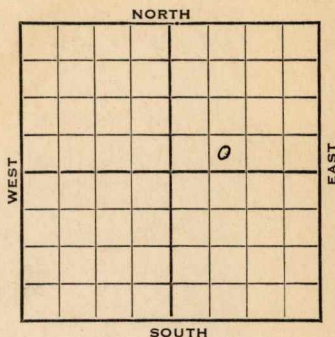

SE SW NE

1943

REPORT

1/13 Machine

1/20 "

1/27 "

2/3 "

2/10 "

2/17 Location abandoned.

Greenwood

KANSAS

Map No. 10 Sec. 12 Twp. 27 R. 8EWell No. 2 Baldwin "A"K. T. Wiedemann CompanyFIRST REPORT Contractor

SE SW NE

 Ft. from N. Line330 Ft. from S. Line Ft. from E. Line990 Ft. from W. Line

SECTION PLAT

MISCELLANEOUS

Location Rig up

Drilling and Remarks:

Machine

RECORD

Cased in., ft.Sand Gas Oil Total Depth

PRODUCTION

1st 24 hrs. Nat. 1st 24 hrs. after shot Gas Cu. Ft.Dry Hole Abandoned

Date


JAN 13 1943 19S. J. LEWIS Scout

Greenwood

KANSASMap No. 10 Sec. 12 Twp. 27 R. 8EWell No. 2 Baldwin "A"K. T. Wiedemann CompanyABANDONED Contractor

SE SW NE

SECTION PLAT

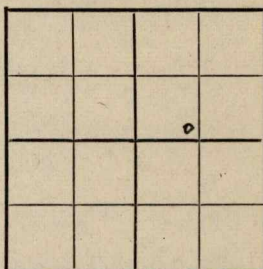 Ft. from N. Line330 Ft. from S. Line Ft. from E. Line990 Ft. from W. Line

MISCELLANEOUS

Location ✓Rig up

Drilling and Remarks:

RECORD

Cased in., ft.Sand Gas Oil Total Depth

PRODUCTION

1st 24 hrs. Nat. 1st 24 hrs. after shot Gas Cu. Ft.Dry Hole Abandoned

Date

FEB 17 1943

19

S. J. LEWIS Scout