


Cowley

KANSAS

SECTION 31 TOWNSHIP 30 RANGE 8E

WELL NO. #1 Ferguson

COMPANY White & Ellis

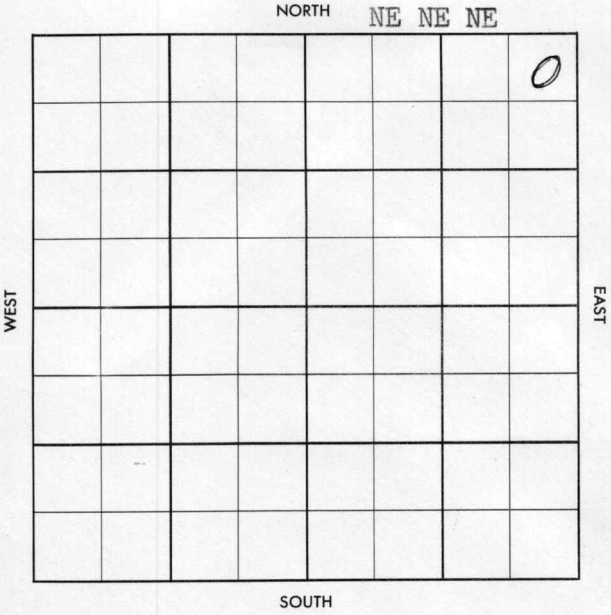

County Cowley Elev. \_\_\_\_\_  
 Sec. 31 Twp. 30 Rge. 8E  
 Company White & Ellis  
 Farm Name Ferguson No. 1

TOPS	DEPTH	LOG	DATUM	Loc. in Sec.
Anh.				NE NE NE
Tp.				
H.				
Tr.				
Dg.				
Bl.				
L.				Geol. _____
K.C.				Contr. _____
B.K.C.				
Ce.				
C.				
M.				Pool _____
M.				
K.				
Mz.				
Mq.				
V.				
S.				
S.				
A.				
R.				
PE.				
G.				
T.D.				

0

FIRST REPORT

MAR 13 57

Date Comm. Phillips Support  
 Loc. \_\_\_\_\_

30

Co.  
Lse.  
No.  
Sec.  
T.  
R.

County Cowley Elev. 1479 grd.  
 Sec. 31 Twp. 30 Rge. 8E  
 Company White & Ellis  
 Farm Name Ferguson No. 1

Co

TOPS	DEPTH	LOG	DATUM
Anh.			
Tr.			
H.		1269	
Fr. <u>Pede</u>		1533	
Dg.			
Bl.			
L.	1587	1587	
K.C.			
<del>B.K.</del> <u>Laysd</u>	1964	1966	
Ce.	2508	2508	
C. <u>RC</u>		2014	
M.	2788	2748	
M.			
K- <u>Pre cowley</u>	2825		
Mz.			
Mo.			
V.			
S.			
S.			
A.	3166	3165	
R.			
PE.			
G.			
T.D.	3216		

Loc. in Sec. NE NE NE

Geol.

Contr.

Pool

		0
	APR 3 '57	
ABANDONED		

Sec.

No.

Date Comm. Phillips Support  
 Loc. MAR 20 '57 3-16-57 8578 101

Sec.

165 DST 1964-70 1 hr. no rec  
BHP 585 ~~3202~~ MAR 27 '57 S.O. front  
2212-16 ~~3202~~ APR 3 '57  
DEA

T.

R.