


Greenwood

Map No. *Kano* Sec. *13* Twp. *27* R. *S*
 Well No. *1* *Denchfield* Farm
Davidson et al Company

NORTH

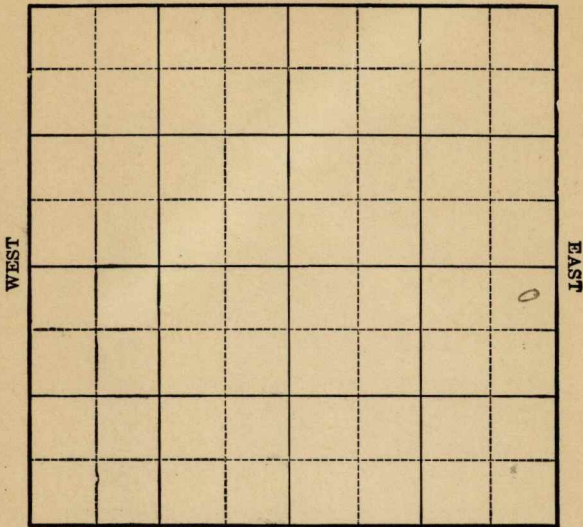

SOUTH

Location _____
 Drilling Remarks _____

Rig Up _____
 Drilling Remarks _____

RECORD

PRODUCTION

Cased _____ in. _____ ft.
 Sand _____
 Gas _____
 Oil _____
 Total Depth _____


1st 24 hrs. Nat. _____
 1st 24 hrs. after shot _____
 Gas _____ cu. ft.
 Dry Hole _____
 Abandoned _____

*Greenwoods*Map No. *11711* Sec. *13* Twp. *27* R. *8*Well No. *1* *Denchfield* Farm
Davidson et al Company*250* Ft. from N. Line

Ft. from S. Line

250 Ft. from E. Line

Ft. from W. Line

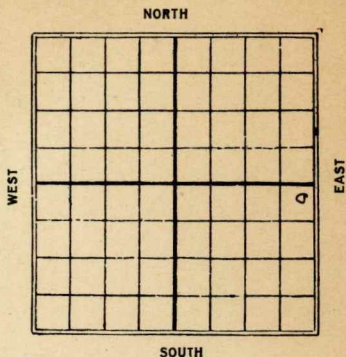*1926*

Date

REPORT

8/25 *Location**8-31**9/15* *_____**9/22* *Aband. location*

Greenwood

10 KANSAS 13 27 8
 Map No. Sec. Twp. R.
 Well No. 1 Denchfield
 Davidson et al Company

Contractor

FIRST REPORTS

SECTION PLAT

250 Ft. from N. Line

Ft. from S. Line

250 Ft. from E. Line

Ft. from W. Line

			o

Formerly owned by Empire.

Location

Rig up

Drilling and Remarks:

RECORD

Cased in., ft.

Sand

Gas

Oil

Total Depth

PRODUCTION

1st 24 hrs. Nat.

1st 24 hrs. after shot

Gas Cu. Ft.

Dry Hole

Abandoned

Date

AUG 25 1926

CHAS. L. SHERWOOD

192

Scout

10 **KANSAS** *Butler*
 Map No. _____ Sec. *13* Twp. *27* R. *8*
 Well No. *1* *Dench fold*
David A. Holt et al Company

Contractor _____

COMPLETED**SECTION PLAT***250* _____ Ft. from N. Line

_____ Ft. from S. Line

250 _____ Ft. from E. Line

_____ Ft. from W. Line

ABANDONED

Location _____

Rig up _____

Drilling and Remarks:

*Loc***RECORD**

Cased _____ in., _____ ft.

Sand _____

Gas _____

Oil _____

Total Depth _____

PRODUCTION

1st 24 hrs. Nat. _____

1st 24 hrs. after shot _____

Gas _____ Cu. Ft.

Dry Hole _____

Abandoned _____

Date

SEP 22 1926

CHAS. L. SHERWOOD

192

Scout