


Map No. _____ Sec. 13 Twp. 27 R. 8
 Well No. 2 Denchfield Farm
Empire Company

NORTH

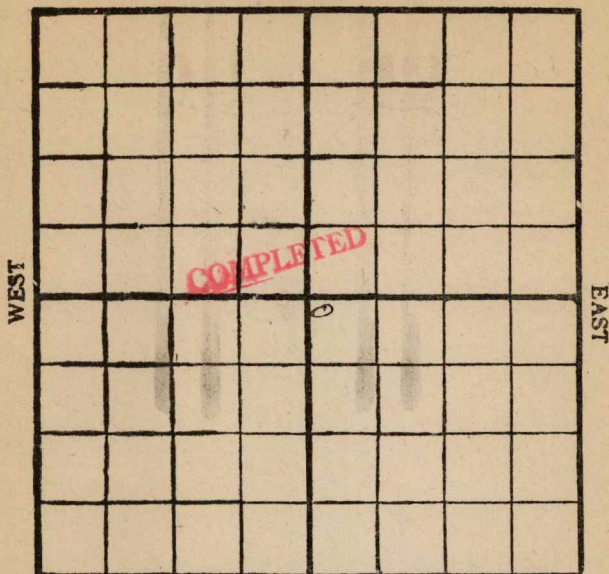

SOUTH

Location _____

Drilling Remarks:

RECORD

Cased _____ in. _____ ft.
 Sand _____
 Gas _____
 Oil _____
 Total Depth _____

Rig Up _____

Drilling Remarks:

PRODUCTION

1st 24 hrs. Nat. _____
 1st 24 hrs. after shot _____
 Gas _____ cu. ft.
 Dry Hole _____
 Abandoned _____

Map No. K10 Sec. 13 Twp. 27 R. 8Well No. 2 WenchfieldEmpire Company

Contractor

NORTH

WEST

EAST

FIRST REPORT

0

SOUTH

264 N-W

Location _____

Rig up. ☒

Drilling and Remarks:

RECORD

Cased _____ in., _____ ft.

Sand _____

Gas _____

Oil _____

Total Depth _____

PRODUCTION

1st 24 hrs. Nat. _____

1st 24 hrs. after shot _____

Gas _____ Cu. Ft.

Dry Hole _____

Abandoned _____

Date

Feb 13 1919Pyle

Scout

Map No. K10 Sec. 13 Twp. 27^S R. 8^E
Well No. 2 Denchfield
Empire Company
Contractor

NORTH

WEST

EAST

SOUTH

RECORD

Location

Cased-----in., -----ft.

Rig up.....

Sand_____

Drilling and Remarks:

Gas

Oil _____

Total Depth_____

PRODUCTION

1st 24 hrs. Nat. _____

1st 24 hrs. after shot-----

Gas.....Cu. Ft.

Dry Hole.....

Abandoned.....

Date _____

191

Pyle

Scout


Map No. K10 Sec. 13 Twp. 27^S R. 9^EWell No. 2 DunfieldEmpire Company

Contractor

NORTH

WEST

EAST

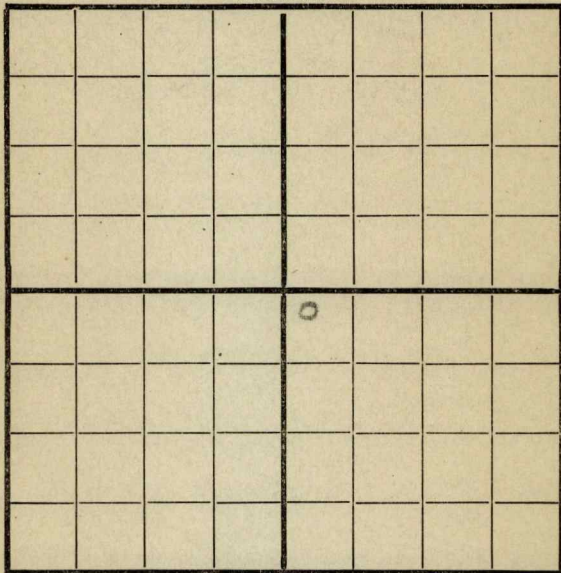

SOUTH

264 N.W.

Location _____

Rig up _____

Drilling and Remarks:

66.5'

RECORD

Cased 12 1/2 in., 385 ft.

Sand _____

Gas _____

Oil _____

Total Depth _____

PRODUCTION

1st 24 hrs. Nat. _____

1st 24 hrs. after shot _____

Gas _____ Cu. Ft.

Dry Hole _____

Abandoned _____

Date

2/251919G. L. Scout

Map No. K10 Sec. 13 Twp. 27 R. 8 ^S ^EWell No. 2 DenchfieldEmpire


Company

Contractor

NORTH

WEST

EAST

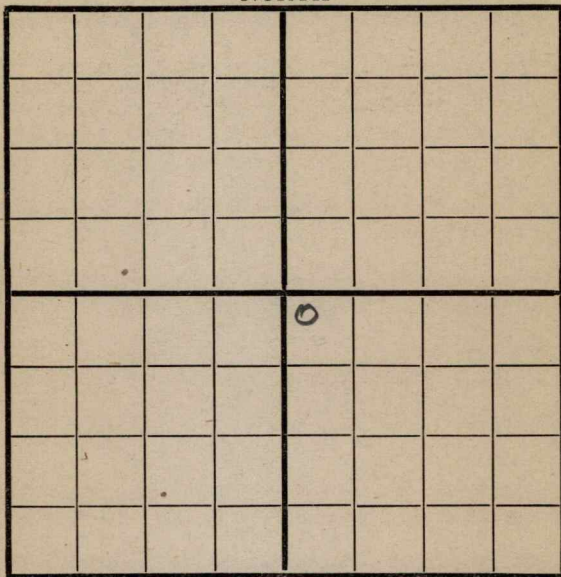264 N-W SOUTH

RECORD

Location _____

Cased _____ in., _____ ft.

Rig up _____

Sand _____

Drilling and Remarks:

Gas _____

Oil _____

Total Depth _____

PRODUCTION

1st 24 hrs. Nat. _____

1st 24 hrs. after shot _____

Gas _____ Cu. Ft.

Dry Hole _____

Abandoned _____

Date

31919

Pyle

Scout


Map No. K10 Sec. 13 Twp. 27 R. 8 EWell No. 2 DenchfieldEmpire Company

Contractor

NORTH

WEST

EAST

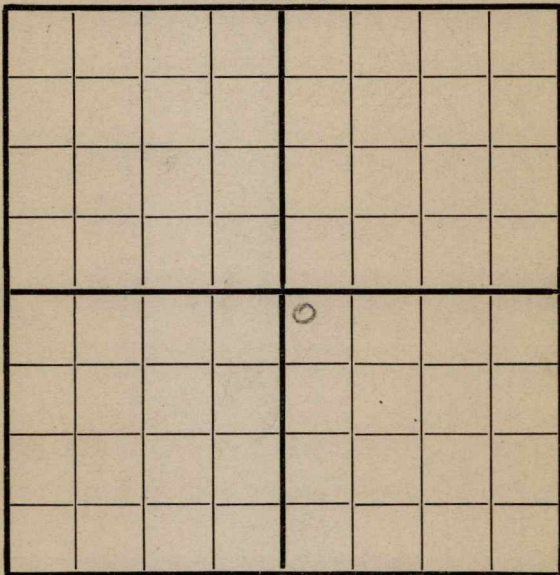

SOUTH

264 N-W

Location _____

Rig up _____

Drilling and Remarks:

D. W.
repairing
rig @ 720

RECORD

Cased _____ in., _____ ft.

Sand _____

Gas _____

Oil _____

Total Depth _____

PRODUCTION

1st 24 hrs. Nat. _____

1st 24 hrs. after shot _____

Gas _____ Cu. Ft.

Dry Hole _____

Abandoned _____

Date

3/12
1919

1919

Oyle
Scout

Scout


Map No. K10 Sec. 13 Twp. 27 R. 8Well No. 2 DunfieldEmpire Company

Contractor

NORTH

WEST

EAST

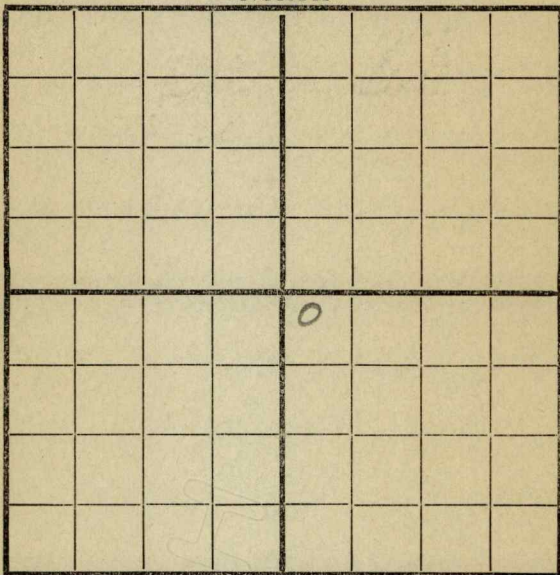264 N-W SOUTH

Location _____

Rig up _____

Drilling and Remarks:

Set 10" @
731'

RECORD

Cased _____ in., _____ ft.

Sand _____

Gas _____

Oil _____

Total Depth _____

PRODUCTION

1st 24 hrs. Nat. _____

1st 24 hrs. after shot _____

Gas _____ Cu. Ft.

Dry Hole _____

Abandoned _____

Date

3/18 1919

Pyle

Scout

Map No. 510 Sec. 13 Twp. 27 R. 8
 Well No. 2 Denchfield
Empire Company
 Contractor

NORTH								
WEST					0			EAST
				SOUTH				

264 N-W

Location _____	RECORD
Rig up _____	Cased _____ in., _____ ft.
Drilling and Remarks:	Sand _____
	Gas _____
	Oil _____
	Total Depth _____
	PRODUCTION
	1st 24 hrs. Nat. _____
	1st 24 hrs. after shot _____
	Gas _____ Cu. Ft.
	Dry Hole _____
	Abandoned _____

Date 3/27 1919 **Pyle** Scout


Map No. K 10 Sec. 13 Twp. 27 R. 8Well No. 2 DanahfieldEmpire Company

Contractor

NORTH

WEST

EAST

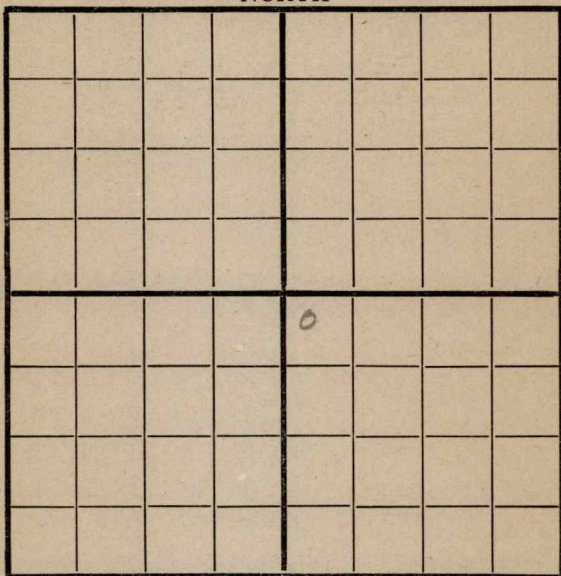

SOUTH

264 N-W

RECORD

Location _____

Cased _____ in., _____ ft.

Rig up _____

Sand _____

Drilling and Remarks:

Gas _____

Oil _____

Total Depth _____

PRODUCTION

1st 24 hrs. Nat. _____

1st 24 hrs. after shot _____

Gas _____ Cu. Ft.

Dry Hole _____

Abandoned _____

Date

Pyle

191


Scout

Map No. K 10 Sec. 13 Twp. 27 R. 8
Well No. 2 Denchfield
Empire Company
Contractor

NORTH

WEST

EAST

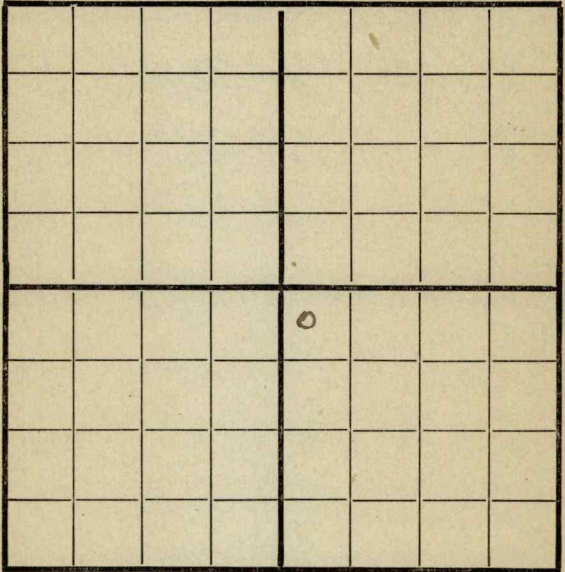

264 N-W SOUTH

Location _____

Rig up _____

Drilling and Remarks:

D. D @
990'

RECORD

Cased _____ in., _____ ft.

Sand _____

Gas _____

Oil _____

Total Depth _____

PRODUCTION

1st 24 hrs. Nat. _____

1st 24 hrs. after shot _____

Gas _____ Cu. Ft.

Dry Hole _____

Abandoned _____

Date

4/8 1919

Pyle

Scout


Map No. K 10 Sec. 13 Twp. 27 R. 8Well No. 2 WenchfieldEmpire Company

Contractor

NORTH

WEST

EAST

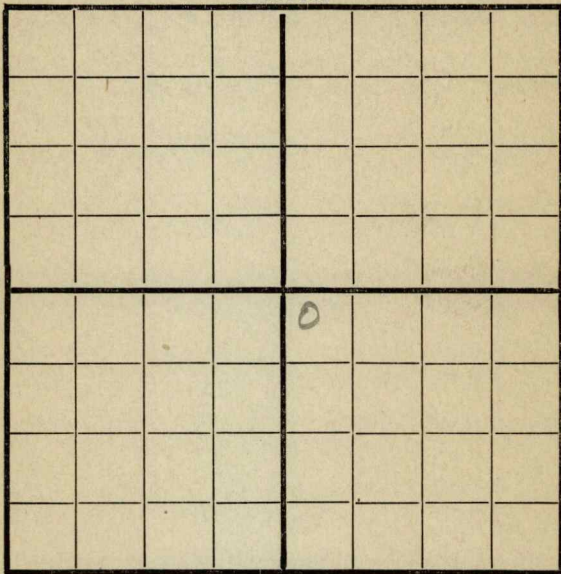

SOUTH

264 N-W

RECORD

Location _____

Cased _____ in., _____ ft.

Rig up _____

Sand _____

Drilling and Remarks:

Gas _____

Oil _____

Total Depth _____

PRODUCTION

1st 24 hrs. Nat. _____

1st 24 hrs. after shot _____

Gas _____ Cu. Ft.

Dry Hole _____

Abandoned _____

Date

Pyle

191 9

Scout

4/17


Map No. K10 Sec. 13 Twp. 27 R. 8Well No. 2 DenchfieldEmpire Company

Contractor

NORTH

WEST

EAST

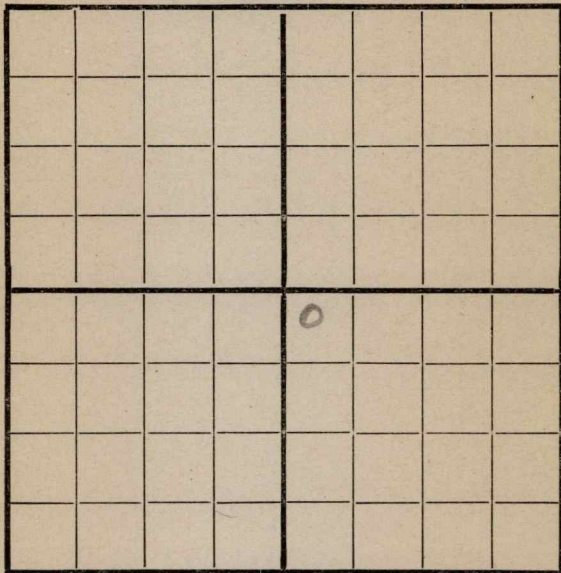264 N-W SOUTH

Location _____

Rig up _____

Drilling and Remarks:

RECORD

Cased _____ in., _____ ft.

Sand _____

Gas _____

Oil _____

Total Depth _____

PRODUCTION

1st 24 hrs. Nat. _____

1st 24 hrs. after shot _____

Gas _____ Cu. Ft.

Dry Hole _____

Abandoned _____


Date

4/23191 9

Pyle

Scout

Map No. K10 Sec. 13 Twp. 27 R. 8
 Well No. 2 Denchfield
Empire Company
 Contractor

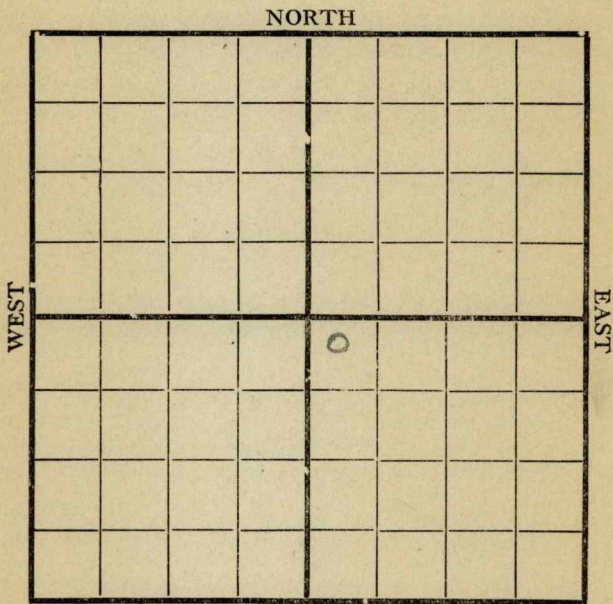

Location _____
 Rig up _____
 Drilling and Remarks:

DD @
1020'

RECORD

Cased _____ in., _____ ft.
 Sand _____
 Gas _____
 Oil _____
 Total Depth _____

PRODUCTION

1st 24 hrs. Nat. _____
 1st 24 hrs. after shot _____
 Gas _____ Cu. Ft.
 Dry Hole _____
 Abandoned _____

Date

5/8

191

9

Pyle

Scout


Map No. *K10* Sec. *13* Twp. *27* R. *8*Well No. *2* *Denchfield**Empire* Company

Contractor

NORTH

WEST

EAST

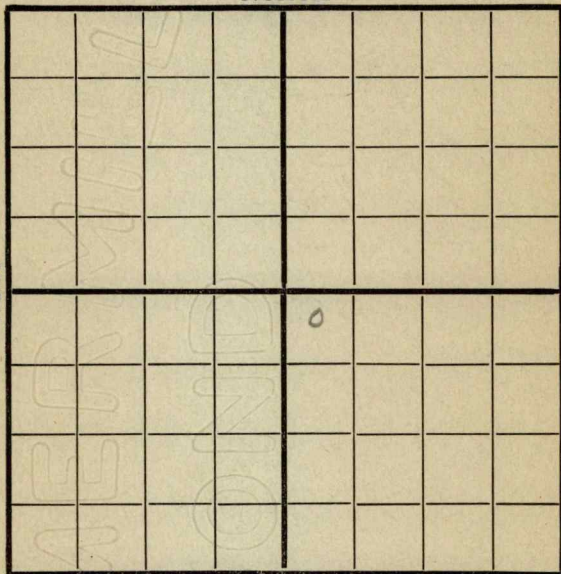

SOUTH

264 N-W

Location _____

Rig up _____

Drilling and Remarks:

*Mudding
off Gas @
1036'*

RECORD

Cased _____ in., _____ ft.

Sand _____

Gas _____

Oil _____

Total Depth _____

PRODUCTION

1st 24 hrs. Nat. _____

1st 24 hrs. after shot _____

Gas _____ Cu. Ft.

Dry Hole _____

Abandoned _____

Date

5/18 191 *9* *Cyle* Scout


Map No. K10 Sec. 13 Twp. 27 R. 8Well No. 2 DunckfieldEmpire Company

Contractor

NORTH

WEST

EAST

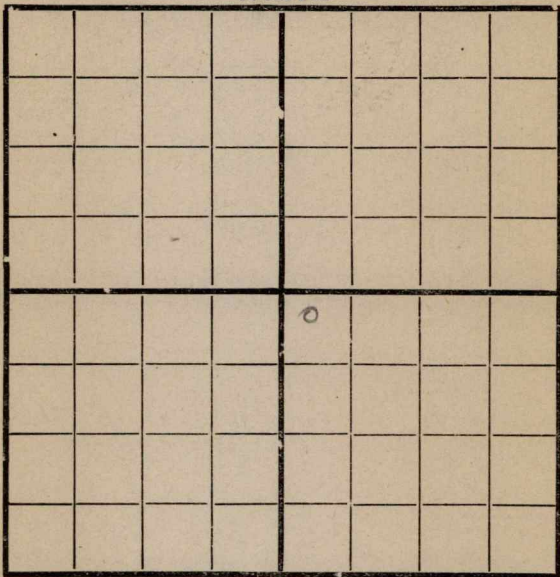

264 N-W SOUTH

Location

Rig up

Drilling and Remarks:

RECORD

Cased _____ in., _____ ft.

Sand _____

Gas _____

Oil _____

Total Depth _____

PRODUCTION

1st 24 hrs. Nat. _____

1st 24 hrs. after shot _____

Gas _____ Cu. Ft.

Dry Hole _____

Abandoned _____

Mudding
off gas @
1036'

Date

1919

Pyle

Scout

3/25


Map No. K 10 Sec. 13 Twp. 27 R. 8Well No. 2 DunckfieldEmpire Company

Contractor

NORTH

WEST

EAST

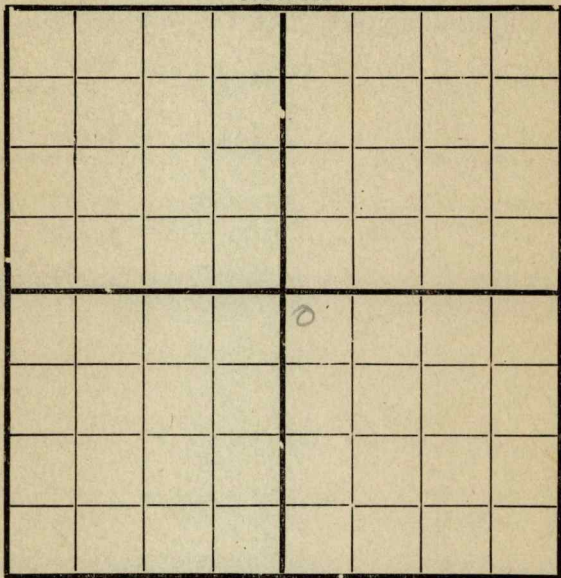264 N-W SOUTH

Location _____

Rig up _____

Drilling and Remarks:

D. R. 65/8to 1054

RECORD

Cased _____ in., _____ ft.

Sand _____

Gas _____

Oil _____

Total Depth _____

PRODUCTION

1st 24 hrs. Nat. _____

1st 24 hrs. after shot _____

Gas _____ Cu. Ft.

Dry Hole _____

Abandoned _____

Date

5/28191 9

Pyle

Scout

Map No. K10 Sec. 13 Twp. 27 R. 8

Well No. 2 Danekfield

Empire

Company

Contractor

NORTH

WEST

EAST

SOUTH

264 N.W.

Location _____

Rig up _____

Drilling and Remarks:

RECORD

Cased _____ in., _____ ft.

Sand _____

Gas 1075-1080

Oil _____

Total Depth.....

PRODUCTION

1st 24 hrs. Nat. -----

1st 24 hrs. after shot-----

Gas 72 Million Cu. Ft.

Dry Hole.....

Abandoned.....

Date _____

6/6

191 9

Pyle

Scout


Map No. 1510 Sec. 13 Twp. 27 R. 8Well No. 2 DanckfieldEmpire Company

Contractor

NORTH

WEST

EAST

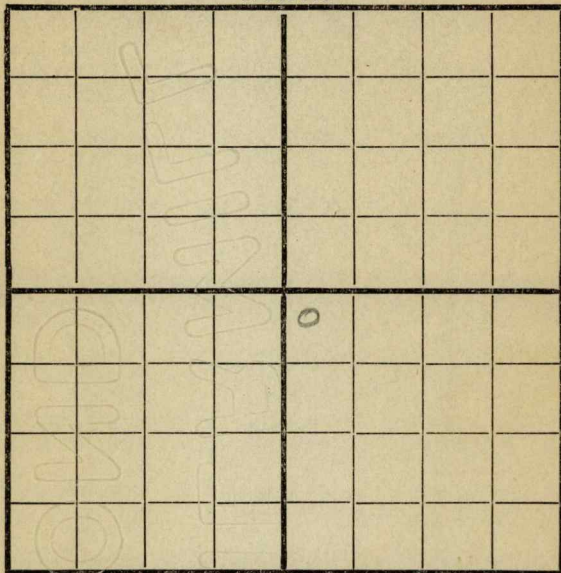

SOUTH

264 N-W

Location _____

Rig up _____

Drilling and Remarks:

Dand 1075

D. D. @ 1082

Show of 1/2 Million
gas.

RECORD

Cased _____ in., _____ ft.

Sand _____

Gas _____

Oil _____

Total Depth _____

PRODUCTION

1st 24 hrs. Nat. _____

1st 24 hrs. after shot _____

Gas _____ Cu. Ft.

Dry Hole _____

Abandoned _____

Date

6/12

1919

Pyle

Scout

Map No. K10 Sec. 13 Twp. 27 R. 8Well No. 2 DenchfieldEmpire


Company

Contractor

NORTH

WEST

EAST

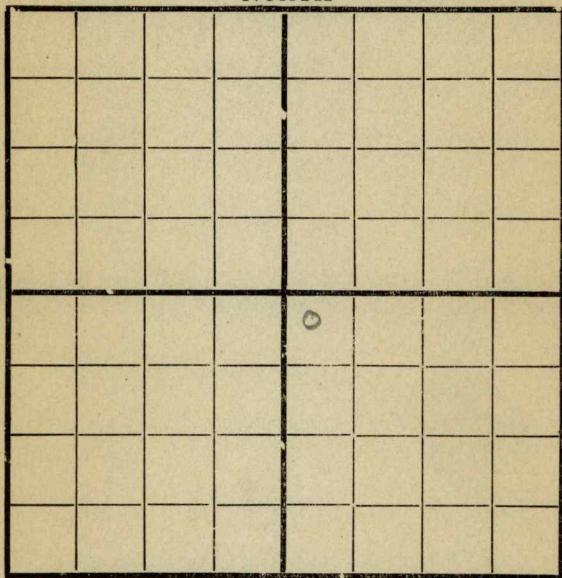

SOUTH

264 N.W.

Location _____

Rig up _____

Drilling and Remarks:

*Mudded in
ready to
test*

RECORD

Cased _____ in., _____ ft.

Sand 1073 - 1089

Gas _____

Oil _____

Total Depth _____

PRODUCTION

1st 24 hrs. Nat. _____

1st 24 hrs. after shot _____

Gas _____ Cu. Ft.

Dry Hole _____

Abandoned _____

Date

6/19 1919Pyle Scout

Map No. K10 Sec. 13 Twp. 27 R. 8Well No. 2 DenchfieldEmpire


Company

Contractor

NORTH

WEST

EAST

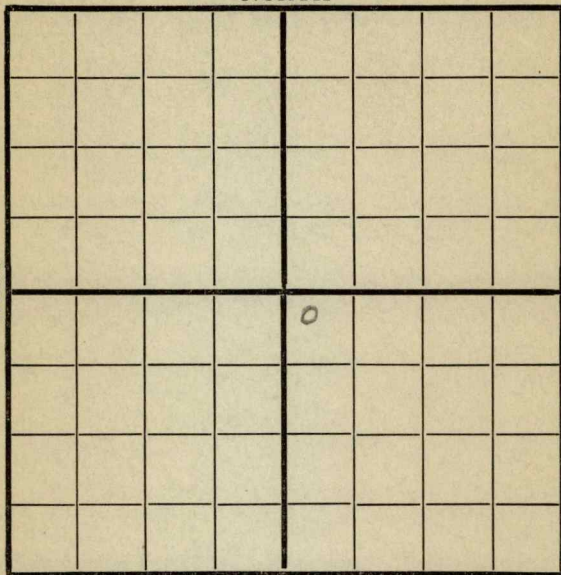

SOUTH

264 N. W.

Location _____

Rig up _____

Drilling and Remarks:

*Mudding
in to get
test.*

RECORD

Cased _____ in., _____ ft.

Sand 1075-1089

Gas _____

Oil _____

Total Depth _____

PRODUCTION

1st 24 hrs. Nat. _____

1st 24 hrs. after shot _____

Gas _____ Cu. Ft.

Dry Hole _____

Abandoned _____

Date

6/26

1919

Pyle


Scout

Map No. K10 Sec. 13 Twp. 27 R. 8Well No. 2 BenchfieldCompany Empire

Contractor _____

NORTH

WEST

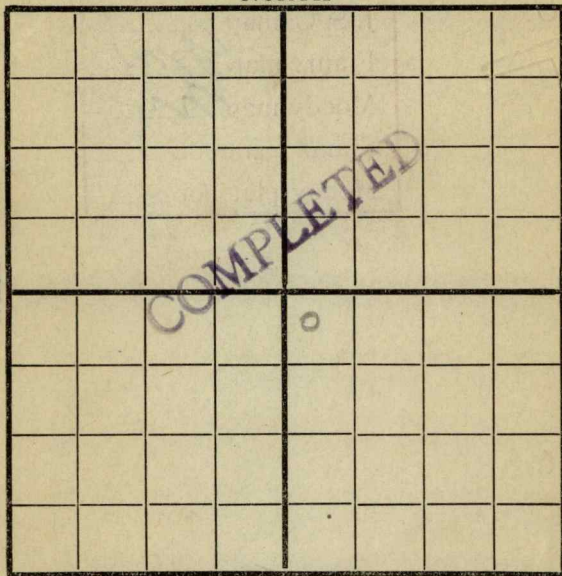

EAST

SOUTH

264 N.W.

Location _____

Rig up _____

Drilling and Remarks:

RECORD

Cased _____ in., _____ ft.

Sand 1075 - 1089

Gas _____

Oil _____

Total Depth _____

PRODUCTION

1st 24 hrs. Nat. _____

1st 24 hrs. after shot _____

Gas 500,000 Cu. Ft.

Dry Hole _____

Abandoned _____

Date

7/51919Pyb

Scout