


Section 14 Township 27 Range 8-E

Well No. 1 Ramp

Company Adair & Morton

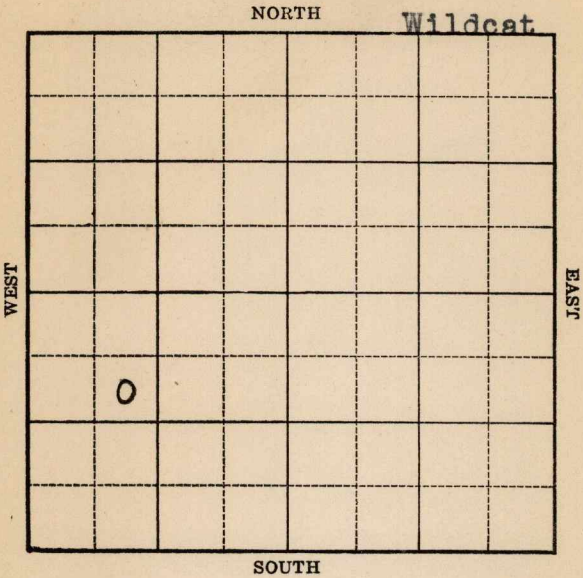


**KANSAS**

Greenwood

Sec. 14 Twp. 27 R. 8-EWell No. #1 Ramp FarmAdair & Morton Company

(Wildcat)

NORTH

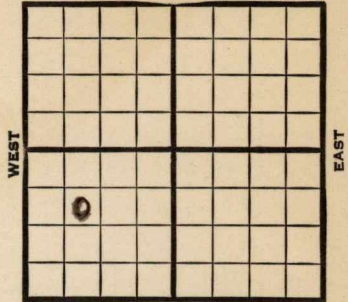

SOUTH

990 Ft. from N. Line       Ft. from S. Line       Ft. from E. Line990 Ft. from W. Line

1939

REPORT

5/24 Machine.

6/1 "

6/8 Drlg. 195'

6/16 S.O. 2060-68' Drlg. 2110'

6/23 Miss. 2662' 6" - 2670'

S. O. 2695-97' Drlg. 2740'

6/29 Arb. 3092' Drlg. 3107'

7/5 Arb. 3092'

T.D. 3137'

No shows.

**ABANDONED**

Greenwood **KANSAS**Map No. 10 Sec. 14 Twp. 27 R. 8EWell No. 1 RampAdair & Morton Company

Contractor

## FIRST REPORT

SE NW SW

990 Ft. from N. Line       Ft. from S. Line       Ft. from E. Line990 Ft. from W. Line

## SECTION PLAT

|  |  |  |  |
|--|--|--|--|
|  |  |  |  |
|  |  |  |  |
|  |  |  |  |
|  |  |  |  |

WILDCAT

Location                                 Rig up                                 

Drilling and Remarks:

**Mach.**

## RECORD

Cased            in.,            ft.Sand                                 Gas                                 Oil                                 Total Depth                                 

## PRODUCTION

1st 24 hrs. Nat.                                 1st 24 hrs. after shot                                 Gas                                  Cu. Ft.Dry Hole                                 Abandoned                                 

Date

MAY 24 1939 19

S. J. LEWIS Scout

Map No. 10 Sec. 14 Twp. 27 R. 8EWell No. 1 RampAdair & Morton

Company

Contractor

ABANDONED  
SE NW SW990 Ft. from N. Line       Ft. from S. Line       Ft. from E. Line990 Ft. from W. Line

## SECTION PLAT

|  |  |  |  |
|--|--|--|--|
|  |  |  |  |
|  |  |  |  |
|  |  |  |  |
|  |  |  |  |

WILDCAT

Location                     Rig up                     

Drilling and Remarks:

*Art 3092**No shows*

## RECORD

Cased            in.,            ft.Sand                     Gas                     Oil                     Total Depth 3137

## PRODUCTION

1st 24 hrs. Nat.                     1st 24 hrs. after shot                     Gas                      Cu. Ft.Dry Hole                     Abandoned                     

Date

JUL 5 1939 19S. J. LEWIS

Scout