

*Clk*


Form 51-5M-2-29-34703

Map No. KANSAS Sec. 25 Twp. 30 R. 9

Well No. 1-1-1 Lagston Farm

Hood & Frazier Company

NORTH

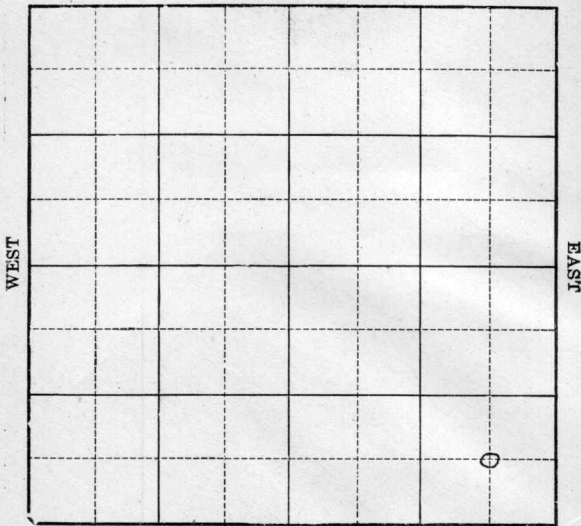

Location \_\_\_\_\_

Drilling Remarks \_\_\_\_\_

\_\_\_\_\_

\_\_\_\_\_

**RECORD**

Cased \_\_\_\_\_ in. \_\_\_\_\_ ft.

Sand \_\_\_\_\_

Gas \_\_\_\_\_

Oil \_\_\_\_\_

Total Depth \_\_\_\_\_

Rig Up \_\_\_\_\_

Drilling Remarks \_\_\_\_\_

\_\_\_\_\_

\_\_\_\_\_

**PRODUCTION**

1st 24 hrs. Nat. \_\_\_\_\_

1st 24 hrs. after shot \_\_\_\_\_

Gas \_\_\_\_\_ cu. ft.

Dry Hole \_\_\_\_\_

Abandoned \_\_\_\_\_

Elk

Map No. KANSAS Sec. 25 Twp. 30 R. 9


Well No. 1 Logston Farm  
Hood & Hrazier Company

\_\_\_\_\_ Ft. from N. Line

660 Ft. from S. Line

660 Ft. from E. Line

\_\_\_\_\_ Ft. from W. Line

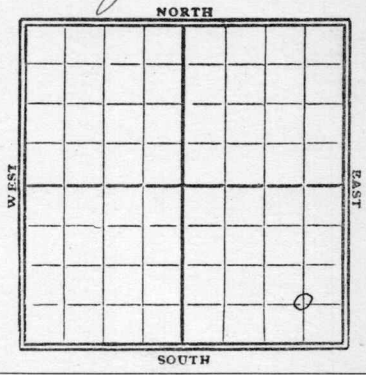

1929

Date

REPORT

4/24

Location

5/11

5/18

Spud

5/15

Drilg 400'

5/22

" 660'

6/5

sand 1450-90

T.D. 1490'

1/4 24 gas

Pump.

10 **KANSAS** <sup>Edk</sup> Sec. 75 Twp. 30 R. 9

Well No. 1 <sup>Logston</sup>

Hood & Frazier Company

Contractor

**SECTION PLAT**

..... Ft. from N. Line

660 Ft. from S. Line

660 Ft. from E. Line

..... Ft. from W. Line


**FIRST REPORTS**

Location

Rig up

Drilling and Remarks:

**RECORD**

Cased..... in., ..... ft.

Sand.....

Gas.....

Oil.....

Total Depth.....

**PRODUCTION**

1st 24 hrs. Nat.....

1st 24 hrs. after shot.....

Gas..... Cu. Ft.

Dry Hole.....

Abandoned.....

Date

APR 24 1929

**CHAS. L. SHERWOOD**

..... 192..... Scout

KANSAS

Elk

Map No. 10 Sec. 25 Twp. 30 R. 9

Well No. 1 hogston

Hood & Frazier Company

Contractor

COMPLETE

SECTION PLAT

			0

Ft. from N. Line

660 Ft. from S. Line

660 Ft. from E. Line

Ft. from W. Line

Location

Rig up

Drilling and Remarks:

RECORD

Cased in., ft.

Sand 1450-1490

Gas

Oil

Total Depth 1490

PRODUCTION

1st 24 hrs. Nat.

1st 24 hrs. after shot

Gas 1/4 AA Cu. Ft.

Dry Hole

Abandoned

Date

JUN 5 1929

CHAS. L. SHERWOOD

192 Scout