

*atk*

Form 51-5M-9-28-27423

Map No. KANSAS Sec. 18 Twp. 30 R. 9

Well No. 1-200y Farm  
Draft & Hunt Company

NORTH

							0

WEST

EAST

SOUTH

Location.....

Drilling Remarks

.....

.....

Rig Up.....

Drilling Remarks

.....

.....

RECORD

Cased..... in..... ft.

Sand.....

Gas.....

Oil.....

Total Depth.....

PRODUCTION

1st 24 hrs. Nat..... ft.

1st 24 hrs. after shot.....

Gas..... cu. ft.....

Dry Hole.....


Abandoned.....

*Elk*

Map No. KANSAS Sec. 18 Twp. 30 R. 9

Well No. 1-Dory Farm  
Croft & Hunt Company

330 Ft. from N. Line  
 \_\_\_\_\_ Ft. from S. Line  
330 Ft. from E. Line  
 \_\_\_\_\_ Ft. from W. Line

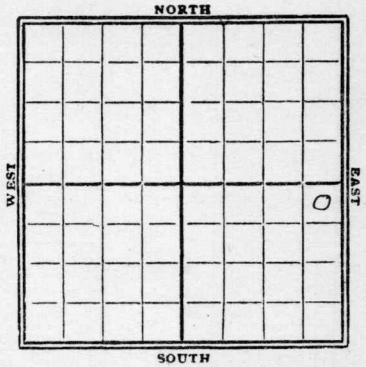

1929

Date	REPORT
2/20	ROG.
2/20	Timbers
2/27	—
3/6	Pig
3/13	Pig up.
3/20	—
3/27	—
4/3	Dory 300'
4/10	—
4/17	Dory 900'
4/24	" 1200'
5/1	" 1450'
5/8	sand 1767-82' 1 M gas
5/15	S.D. 1957'
5/22	—
5/29	Dory 2530'
6/5	" 2540'
6/12	" 2540'
6/19	Top line 2552' Pay 2567-81' T.D. shot 80gts - swab 70 bbl

6/26- Top line 2552'

Pay 2567-81'

T.D. 2581'

shot 80 gts

50 bbls oil

Comp.

Map No. *110* **KANSAS** Sec. *18* Twp. *30* R. *9*

Well No. *1*

*Croft & Hunt* Company

Contractor

**FIRST REPORTS**

*330* Ft. from N. Line

Ft. from S. Line

*330* Ft. from E. Line

Ft. from W. Line

**SECTION PLAT**

			0

Location *R.O.S.*

Rig up

Drilling and Remarks:

**RECORD**

Cased.....in., .....ft.

Sand.....

Gas.....

Oil.....

Total Depth.....

**PRODUCTION**

1st 24 hrs. Nat.....

1st 24 hrs. after shot.....

Gas.....Cu. Ft.

Dry Hole.....

Abandoned.....

Date

**FEB 20 1929**

**CHAS. L. SHERWOOD**

192..... Scout

10 Map No. **KANSAS** Sec. 18 Twp. 30 R. 9

Well No. 1 Dory

Croft & Hunt

Company

Contractor

**COMPLETE**

330 Ft. from N. Line

Ft. from S. Line

330 Ft. from E. Line

Ft. from W. Line

**SECTION PLAT**


Location

Rig up

Drilling and Remarks:

top L 7552'

80/50 Bls.

**RECORD**

Cased in., ft.

Sand by 7567-81

Gas

Oil

Total Depth 7581

**PRODUCTION**

1st 24 hrs. Nat.

1st 24 hrs. after shot

Gas Cu. Ft.

Dry Hole

Abandoned

Date

JUN 26 1929

192

**CHAS. L. SHERWOOD**

Scout