


*Cowley*

Map No. **KANSAS** Sec. 20 Twp. 31 R. 6<sup>E</sup>

Well No. 1-Harris Farm  
Mid-Kansas Oil Company

NORTH

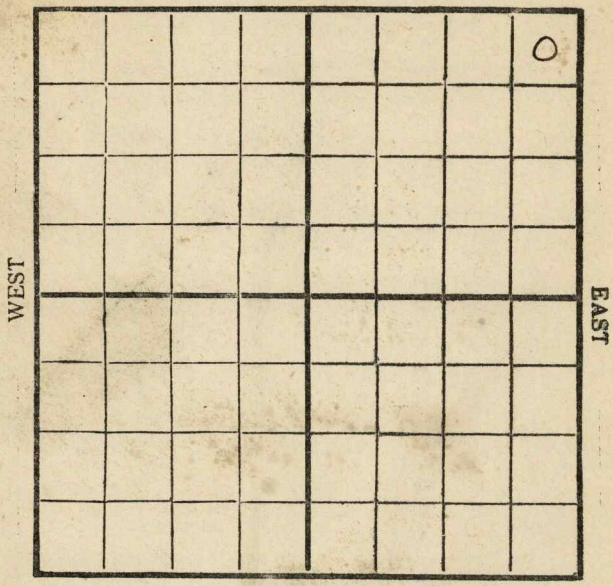

Location \_\_\_\_\_

Drilling Remarks \_\_\_\_\_

\_\_\_\_\_

\_\_\_\_\_

Rig Up \_\_\_\_\_

Drilling Remarks \_\_\_\_\_

\_\_\_\_\_

\_\_\_\_\_

RECORD

Cased \_\_\_\_\_ in. \_\_\_\_\_ ft.

Sand \_\_\_\_\_

Gas \_\_\_\_\_

Oil \_\_\_\_\_

Total Depth \_\_\_\_\_

PRODUCTION

1st 24 hrs. Nat. \_\_\_\_\_

1st 24 hrs. after shot \_\_\_\_\_

Gas \_\_\_\_\_ cu. ft. \_\_\_\_\_

Dry Hole \_\_\_\_\_

Abandoned \_\_\_\_\_

Cowley

Map No. **KANSAS** Sec. 20 Twp. 31 R. 6<sup>E</sup>

Well No. 1 - Harris Farm


Mid-Kansas Oil Company

330 Ft. from N. Line

\_\_\_\_\_ Ft. from S. Line

330 Ft. from E. Line

\_\_\_\_\_ Ft. from W. Line

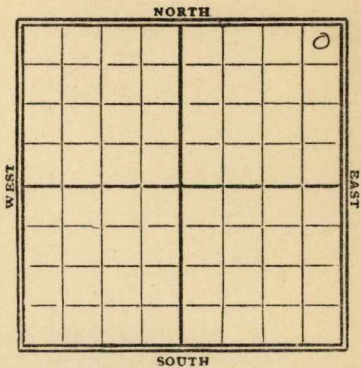

1929

Date	REPORT
8/7	Location
8/7	—
8/14	—
8/21	—
8/28	—
9/14	Rig
9/11	Spdy.
9/18	Wrlg 580'
9/25	" 1260'
10/2	" 1540'
10/19	3 A gas 1537-50' UPC 10"-1605'
10/16	Wrlg 1610'
10/23	T.D. 1610' Run up.
10/30	sand 1610-20' Est 13 A gas Will deepen
11/6	sand 1610-25' 25 A gas - 500# R.P.
11/13	—
11/20	T.D. 1635' Trying to mud off gas

11/27- log 1636'

12/4

12/11

12/23- Dry 1775'

12/30- sand 2213-15'

Est 40 ft gas

1930  
1/8- Gas mudded off

Dep 6" - 2228'

1/15- Dry cm. 2228'

1/22- Dry 2396'

1/29- " 2730'

2/4 - Sandy lime 2805-71

Top lime 2910

S. D. 2922

2/11 -

2/19- 4 bailers water

2990-95- Dry 3015'

2/26- dry 3140' lime

3/5- Dry 3240'

3/12- HFW- 3322-

Dry 3330'

3/19- Top silc lime 3350

T.D. 3451' HFW

Dry & abandon

*Cowley*

Map No. **2** **KANSAS** Sec. *20* Twp. *31* R. *6E*

Well No. *1* *Harris*

*Mid-Kansas* *Oil* Company

Contractor

**FIRST REPORTS**

**SECTION PLAT**

*330* Ft. from N. Line

Ft. from S. Line

*330* Ft. from E. Line

Ft. from W. Line

			<i>0</i>

Location

Rig up

Drilling and Remarks:

**RECORD**

Cased ..... in., ..... ft.

Sand .....

Gas .....

Oil .....

Total Depth .....

**PRODUCTION**

1st 24 hrs. Nat. ....

1st 24 hrs. after shot .....

Gas ..... Cu. Ft.

Dry Hole .....

Abandoned .....

Date

**AUG 7 1929**

**CHAS. L. SHERWOOD**

192 ..... Scout

*Dowley*

2  
Map No. **KANSAS** Sec. *20* Twp. *31* R. *6*

Well No. *1 Harris*

*Mid-Kansas Oil Co* Company

Contractor

**COMPLETE**

SECTION PLAT

*330* Ft. from N. Line

..... Ft. from S. Line

*330* Ft. from E. Line

..... Ft. from W. Line

			<i>0</i>

**ABANDONED**

Location.....

Rig up.....

Drilling and Remarks:

*top side line  
3350'*

RECORD

Cased..... in., ..... ft.

Sand.....

Gas.....

Oil.....

Total Depth *3451 Hew*

PRODUCTION

1st 24 hrs. Nat.....

1st 24 hrs. after shot.....

Gas..... Cu. Ft.

Dry Hole

Abandoned

Date

**MAR 19 1930**

**CHAS. L. SHERWOOD**

.....192..... Scout