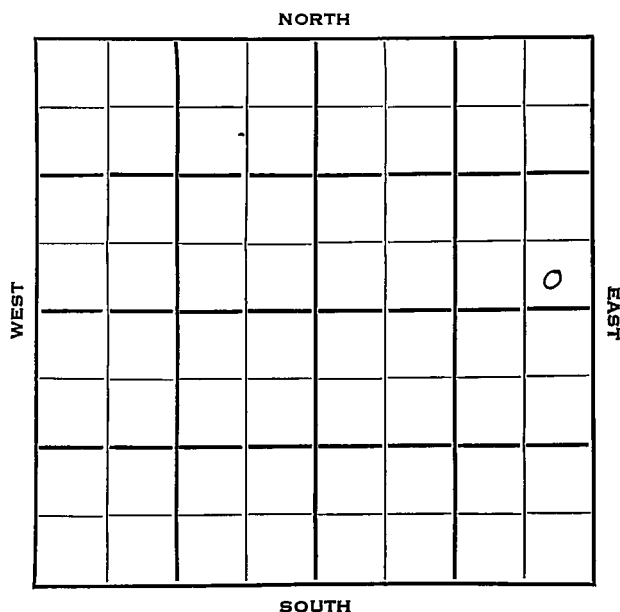


Section 16 Township 18 Range 11WWell No. 1 McGinnisCompany Shelly-Miller

Barton KANSAS

Sec. 16 Twp. 18 R. 14 W

Well No. # 1 McGinnis Farm

Shelly-Miller Company

Shelly-Miller Contractor
Wildcat


Ft. from N. Line

330 Ft. from S. Line

330 Ft. from E. Line

Ft. from W. Line

SE SE NE

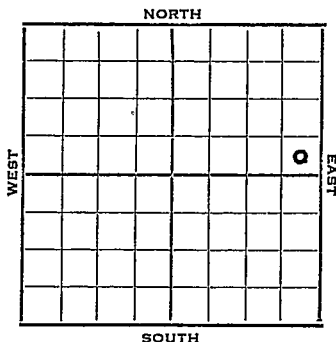

1953 Elev. 1946' REPORT

4/8 Spud 4-2-53
8" @ 892 Anhy 892'
Drlg. 2100'

4/15 Spud 4-2-53
D&A
TD 3476
8" @ 892
Anhy 892, Heeb 3122, Br lime 3195,
Lans 3209
DST 3232-75, opn $\frac{1}{2}$ hrs., rec. 7' mud
DST 3352-75, opn 1 hr., rec. 20'
socm,
Cong 3420, Arb. 3446
DST 3447-55, opn 1 hr., rec. 27' mud
170#
TD 3476
D&A

ABANDONED


County Barton State Kansas
 Sec. 16 (Blk. Twp.) 18 (Sur. Rge.) 14W Map No. _____
 Operator Shelly-Miller
 Well No. 1 Farm McGinnis
 Elev. _____ Location SE SE NE

330 Ft. From S Line NE
330 Ft. From E Line Quarter
 1st. Report APR 8 1953
 Completion _____
 Remarks Shelly-Miller - Contr.
 Spudding Date 4-2-53

Drlg. Data Wildcat
8" @ 892 Anhy 892 drlg. 2100

J. G. McGEHEE

County Barton State Kansas
 Sec. 16 (Blk.) 18 (Sur.) 14W Map No.
 Operator Shelly-Miller
 Well No. 1 Farm McGinnis
 Elev. 1946 Location SE SE NE

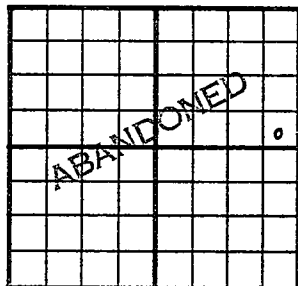

330 Ft. From S Line NE
330 Ft. From E Line Quarter
 Ist. Report
 Completion APR 15 1953
 Remarks Wildcat
Shelly-Miller - Contr.
 Spudding Date 4-2-53
 Drlg. Data D & A TD 3476

8" @ 892 Anhy 892 Heeb. 3122
Br. lime 3195 Lans. 3209 DST 3232-75
open $\frac{1}{2}$ hr. Rec. 7' mud DST 3352-75
open 1 hr. Rec. 20' socm Cong. 3420
Arb. 3446 DST 3447-55 open 1 hr.
Rec. 27' mud 170# TD 3476

D & A