


KANSAS Barton County

Section 18 Township 18 Range 14W

Well No. #1 Snyder

Company Helmerick & Payne

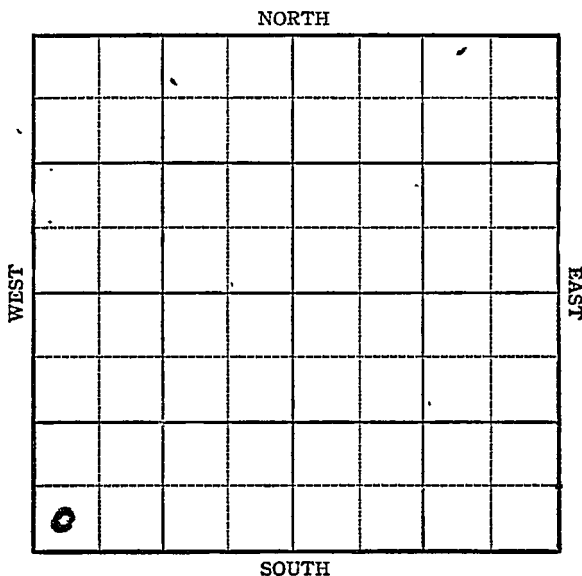

KANSAS

Barton County

Sec. 18 Twp. 18S R. 14W

Well No. #1, Snyder Farm

Helmerick & Payne Company

Boyd

 Ft. from N. Line


330 Ft. from S. Line

 Ft. from E. Line

330 Ft. from W. Line

SW/c

Elev. 1922

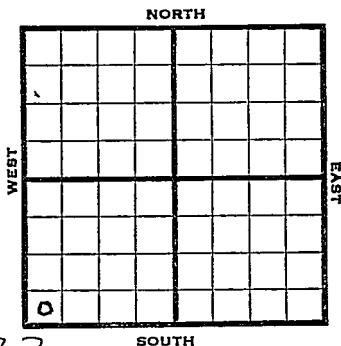

1945

R E P O R T

1-3 Anhydrite 831'
 Drilling 841'

1/10 10" @ 941 WOC

1/17 Drlg 3096

1/26 Lans 3251
 Arb. 3522
 Drlg. 3725

1/31 Basal sd. 3726
 TD 3731

ABANDONED

Pool Name BoydMap No. 73 Sec. 18 Twp. 18 R. 14WWell No. 1 SnyderHelmerick & Payne Company

FIRST REPORT

Contractor

SW/c

SECTION PLAT

_____ Ft. from N. Line

330 Ft. from S. Line

_____ Ft. from E. Line

330 Ft. from W. LineBarton

Location _____

Rig up _____

Drilling and Remarks:

enh~~y~~ 831

841

RECORD

Cased _____ in., _____ ft.

Sand _____

Gas _____

Oil _____

Total Depth _____

PRODUCTION

1st 24 hrs. Nat. _____

1st 24 hrs. after shot _____

Gas _____ Cu. Ft.

Dry Hole _____

Abandoned _____

Date

JAN 3 1945 19S. J. LEWIS Scout

Pool Name BoydMap No. 73 Sec. 18 Twp. 18 R. 14WWell No. 1 SnyderHelmerick & Payne CompanyABANDONED Contractor

SW/c

SECTION PLAT

 Ft. from N. Line330 Ft. from S. Line Ft. from E. Line330 Ft. from W. Line

0			

BartonLocation Rig up

Drilling and Remarks:

Base Lot 3726

RECORD

Cased in., ft.Sand Gas Oil Total Depth 3721

PRODUCTION *

1st 24 hrs. Nat. 1st 24 hrs. after shot Gas Cu. Ft.Dry Hole Abandoned

Date

JAN 31 1945 19S. J. LEWIS Scout