

Map No. Elk KANSAS Sec. 34 Twp. 30 R. 9^E

Well No. 1- Stephens Farm
Union Oil Co Company

NORTH

WEST

EAST

				O			

SOUTH

Location.....

Drilling Remarks

.....

.....

RECORD

Cased..... in..... ft.

Sand.....

Gas.....

Oil.....

Total Depth.....

Rig Up.....

Drilling Remarks

.....

.....

PRODUCTION

1st 24 hrs. Nat.....

1st 24 hrs. after shot.....

Gas..... cu. ft.....

Dry Hole.....

Abandoned.....


Map No. KANSAS Sec. 34 Twp. 30 R. 9E
 Well No. 1- Sycphus Farm
Union Oil Company

990 Ft. from N. Line

..... Ft. from S. Line

..... Ft. from E. Line

330 Ft. from W. Line

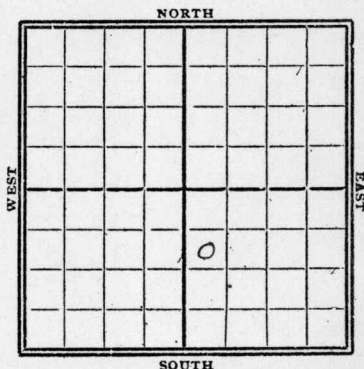

1929

Date

REPORT

6/19	Machine
6/26	Rig up
7/2	Drly 400'
7/10	" 617'
7/17	" 700'
7/24	" 810'
7/31	" 915'
8/7	UHR at 1010'
8/14	Drly 1280'
8/21	" 1500
8/28	" 1850
9/4	SD. 1880'
9/11	—
9/18	—
9/25	—
10/2	—
10/9	Drly 2015'
10/16	Top line 2337'
	Drly 2391'
10/23	Top line 2391'
	T.D. 2412' HFW
	Dry & Abandon

Map No. **KANSAS** Sec. 34 Twp. 30 R. 9E

Well No. 1 Seyphers

Union O. & G. Company

Contractor

SECTION PLAT

990 Ft. from N. Line

..... Ft. from S. Line

..... Ft. from E. Line

330 Ft. from W. Line

		0	

FIRST REPORTS

Location.....

Rig up.....

Drilling and Remarks:

Mach.

RECORD

Cased..... in., ft.

Sand.....

Gas.....

Oil.....

Total Depth.....

PRODUCTION

1st 24 hrs. Nat.....

1st 24 hrs. after shot.....

Gas..... Cu. Ft.

Dry Hole.....

Abandoned.....

Date

JUN 19 1929

CHAS. L. SHERWOOD

Scout

Map No. KANSAS Sec. 34 Twp. 30 R. 9

Well No. 1 Seyphers

Union Oil Gas Company

Contractor

COMPLETE

SECTION PLAT

990 Ft. from N. Line

Ft. from S. Line

Ft. from E. Line

330 Ft. from W. Line

ABANDONED

Location

Rig up

Drilling and Remarks:

Tap Limer 7391'

RECORD

Cased _____ in., _____ ft.

Sand _____

Gas _____

Oil _____

Total Depth 2412 NFW

PRODUCTION

1st 24 hrs. Nat. _____

1st 24 hrs. after shot _____

Gas _____ Cu. Ft.

Dry Hole ☒

Abandoned ☒

Date

OCT 23 1929

CHAS. L. SHERWOOD

192 _____ Scout