

DX 78-1


Barton

KANSAS

Section 8 Township 20 Range 12W

Well No. #4 Walters

Company Hilton Drlg.

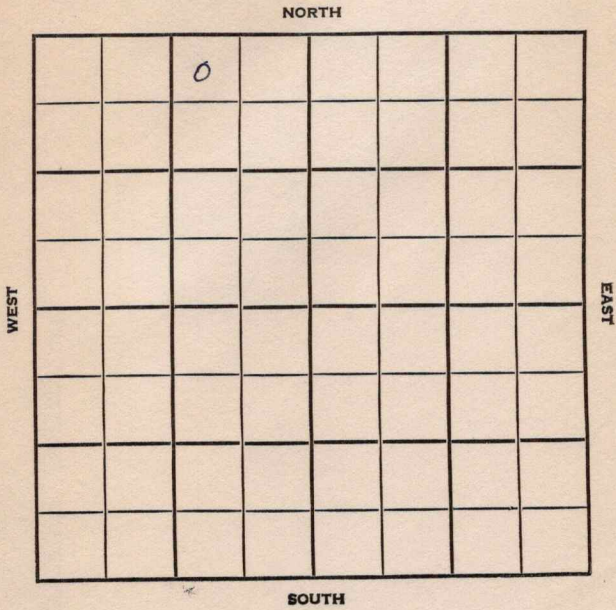

SEC.	TWP.	R.
8	20	12W

WELL NO.

4 Walters

FARM

COMPANY

Hilton Drlg.

CONTRACTOR

Co. Tools


330 _____ Ft. from N. Line

_____ Ft. from S. Line

990 _____ Ft. from E. Line

_____ Ft. from W. Line

NW NE NW

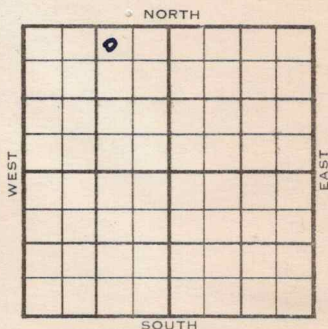

1954

ELEVATION

1845'

REPORT

11/17

Spud 11-11-54

8" @ 130'

Drlg. 1480'

1955
1/5

Spud 11-11-54 - Oil Well

TD 3440'

8" @ 130'

Heeb. 3039', Br. lime 3155', ans.
3171'DST 3160-3210', opn $\frac{1}{2}$ hrs., rec. 7'
mud, 8#DST 3210-38', opn $\frac{1}{2}$ hrs., rec. 2' mud
180#DST 3238-55', opn 1 hr., rec. 15' mud
32#DST 3300-21', opn 1 hr., rec. 720'
gas, 55' hocm, 940#DST 3334-72', opn 1 hr., rec. 10'
mud, VSSO, 90#

Ero Arb. 3409', Arb. 3420'

DST 3420-31', opn $1\frac{1}{2}$ hrs., rec. 15'
mud, 250#DST 3431-40', opn $1\frac{1}{2}$ hrs., rec.
10' mud, 1 gal. free oil, 640#

TD 3440'

5" @ 3438'

OVER

741603

(Information Brought Forward)

1955

1/5

CO to 3 440'

48/3430-38', 250A

S/1 boph 5% wtr., 500A

S/2 $\frac{1}{2}$ boph 5% wtr.

Comp. 70 bopd

COMPLETED

County Barton State KansasSec. 8 (Blk.) 20 (Sur.) 12W Map No.Operator Hilton Drlg.Well No. 4 Farm WaltersElev. 1845 Location NW NE NW

		0					

330 Ft. From N Line NW990 Ft. From E Line Quarter1st. Report NOV 17 1954

Completion

Remarks

Co. toolsSpudding Date 11-11-54

Drlg. Data

8" @ 130 drlg. 1480

FABEN GILSTRAP

County Barton State Kansas
 Sec. 8 (Blk.) 20 (Sur.) 12W Map No.
 Operator Hilton Drlg.
 Well No. 4 Farm Walters
 Elev. 1845 Location NW NE NW

330 Ft. From N Line NW
990 Ft. From E Line Quarter

1st. Report

Completion JAN 5 1955

Remarks

Co. tools

Spudding Date 11-11-54

Drlg. Data Oil well TD 3440

8" @ 130 Heeb. 3039 Br. lime 3155

Lans. 3171 DST 3160-3210 open $\frac{1}{2}$ hr.

Rec. 7' mud 8# DST 3210-38 open $\frac{1}{2}$ hr.

Rec. 2' mud 180# DST 3238-55

open 1 hr. Rec. 15' mud 32# DST 3300-

21 open 1 hr. Rec. 720' gas 55' hoem

940# DST 3334-72 open 1 hr. Rec. 10'

mud VSSO 90# EroArb. 3409

Arb. 3420 DST 3420-31 open $1\frac{1}{2}$ hr.

Rec. 15' mud 250# DST 3431-40 open

$1\frac{1}{2}$ hr. Rec. 10' mud 1 gal. free oil

640# TD 3440 5" @ 3438 CO to 3440

48/ 3430-38 250 A S/ 1 boph 5% wtr.

500 A S/ $2\frac{1}{2}$ boph 5% wtr.

Comp. 70 bopd

FABEN GILSTRAP