

Barton

DX 78-1

KANSAS

Section 8 Township 20 Range 12W

Well No. #3 Walters

Company Hilton Drlg. Co.

NORTH

WEST

EAST

0							

SOUTH

Barton

KANSAS

SEC.	TWP.	R.
8	20	12W
WELL NO.		

COMPANY #3 Walters FARM

CONTRACTOR Hilton Drlg. Co.

Hilton Tools.

Sunny Valley Pool NORTH


990 Ft. from N. Line

Ft. from S. Line

Ft. from E. Line

330 Ft. from W. Line

SW NW NW

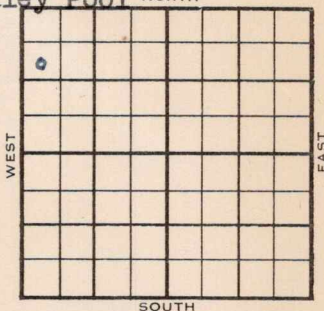

	ELEVATION	REPORT
1954	1838'	


9/22 Spud 9-18-54
8" @ 122' w/175 sks
Drlg. 425'

10/6 Spud 9-18-54
D & A
TD 3439'
8" @ 122'
Heeb 3041', Br. Lime 3159' Lans 3172
DST 3192'-3252' opn 1 hr, rec 65' wcm,
910# Arb. 3420',
DST 3420'-29' opn 1 hr, rec 6' Mud,
220#
DST 3429'-39' opn 1 hr, rec 6' Mud
50#
TD 3439'
D & A

ABANDONED

8" @ 122 w/175, Drlg 425

FABEN GILSTRAP

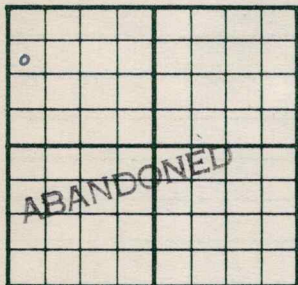County Barton State KansasSec. 8 (Blk.
Twp.) 20 (Sur.
Rge.) 12W Map No.Operator Hilton Drlg.Well No. 3 Farm WaltersElev. 1838 Location SW NW NW990 Ft. From N Line NW330 Ft. From W Line Quarter

1st. Report _____

Completion OCT 6 1954Remarks Sunny Valley PoolHilton - Contr.Spudding Date 9-18-54Drlg. Data D & A TD 34398" @ 122 Heeb. 3041 Br. lime 3159Lans. 3172 DST 3192-3252 open 1 hr.Rec. 65' wcm 910# Arb. 3420DST 3420-29 open 1 hr. Rec. 6' mud220# DST 3429-39 open 1 hr. Rec. 6'mud 50# TD 3439D & A

FABEN GILSTRAP