


Map No. **KANSAS** Sec. 20 Twp. 31 R. 6 E
 Well No. 2 Headley Farm
Slick P & L Company

Cowley

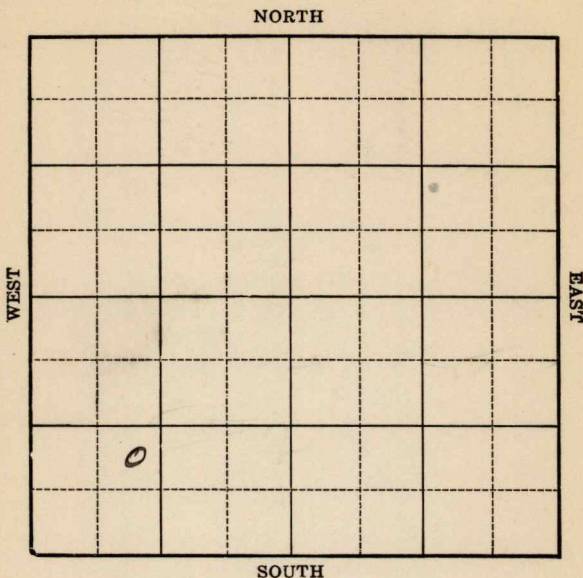

Location _____

Drilling Remarks _____

Rig Up _____

Drilling Remarks _____

RECORD

Cased _____ in. _____ ft.

Sand _____

Gas _____

Oil _____

Total Depth _____

PRODUCTION

1st 24 hrs. Nat. _____

1st 24 hrs. after shot _____

Gas _____ cu. ft.

Dry Hole _____

Abandoned _____

Cowley

Map No. **KANSAS** Sec. 20 Twp. 31 R. 6E


Slick P & L. Company

 Ft. from N. Line

990 Ft. from S. Line

 Ft. from E. Line

990 Ft. from W. Line

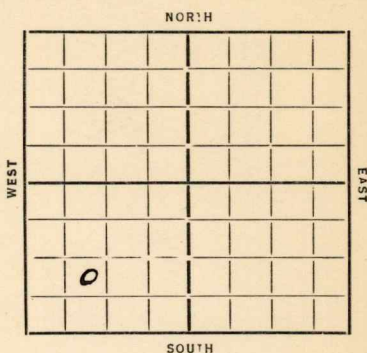

Date 1934

REPORT

8/8 Rgn up
8/16 — 8/25 —
8/30 Rgn
9/6 Spud
9/13 Dlg 450
9/20 " 1080 12" 1016
9/27 " 1500
10/4 10" 1449 8" 1660 6" 1990
K.C. 2258 Dlg 2450 → 2864
10/11 Birt Sand 2857 5"-2860
Dlg 2890
10/18 Birt 2864 Corrected
TJ 2929 60 gts C.O.
10/25 Est 25 Bbls per day
11/1 Tubing
11/7 Birt 2864 TJ 2929
25 Bbls.

COMPLETED

KANSAS

Map No. 2 Sec. 20 Twp. 31 R. 6²Well No. 2-HeadleySlick P & L Company

Contractor

SECTION PLAT

FIRST REPORTS

 Ft. from N. Line990 Ft. from S. Line Ft. from E. Line990 Ft. from W. Line

0			

Location Rig up

Drilling and Remarks:

Rig on up

RECORD

Cased in., ft.Sand Gas Oil Total Depth

PRODUCTION

1st 24 hrs. Nat. 1st 24 hrs. after shot Gas Cu. Ft.Dry Hole Abandoned

Date

8/8/34

19

ORVAL MANNSCHRECK

Scout

RAJ

KANSAS

Map No. 2 Sec. 20 Twp. 31 R. 68

Well No. 2-Headley

Slicker & Lockhart Company

Contractor

COMPLETED

SECTION PLAT

Ft. from N. Line

990

Ft. from S. Line

Ft. from E. Line

990

Ft. from W. Line

Location

Rig up

Drilling and Remarks:

25 fth

RECORD

Cased in. ft.

Sand 2864

Gas

Oil

Total Depth 2929

PRODUCTION

1st 24 hrs. Nat.

1st 24 hrs. after shot

Gas Cu. Ft.

Dry Hole

Abandoned

Date

11-7-37

192

ORVAL MANNSCHRECK

Scout