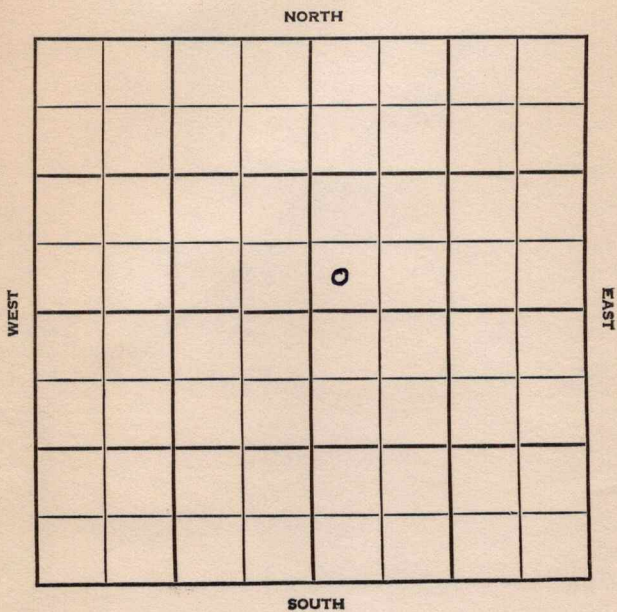


Section 9 Township 20 Range 12WWell No. 1 DahmCompany Lee Philips

Barton KANSAS

SEC.	TWP.	R.
9	20	12W

WELL NO.

1 Dahm

FARM

COMPANY

Lee Philips

CONTRACTOR


Wildcat

Ft. from N. Line

Ft. from S. Line

Ft. from E. Line

Ft. from W. Line

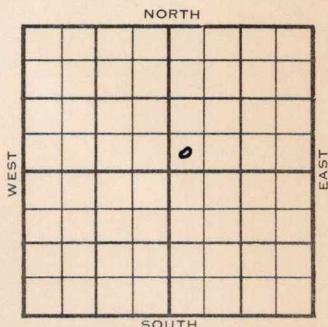

SW SW NE

	ELEVATION	REPORT
1954	1820	

6/15 Spdg 6-10-54
8" @ 250
Anhy 625
Drlg. 2130

6/23 Spud 6-10-54
D & A TD 3420' 8" @ 250
Anhy 625' Top. 2755' Heeb 3006'
Tor. 3031' Br. lime 3125'
Lans. 3139' Cong. 3382' Arb. 3410'
TD 3420' D & A

ABANDONED

County **Barton** State **Kansas**
 Sec. **9** (Blk.) **20** (Sur.) **12W** Map No.
 Operator **Lee Phillips**
 Well No. **1** Farm **Dahm**
 Elev. Location **SW SW NE**

FIRST REPORT

330 Ft. From **S** Line **NE**
330 Ft. From **W** Line **Quarter**
 Ist. Report **JUN 15 1954**
 Completion
 Remarks

Spudding Date **6-10-54**

Drlg. Data **Wildcat**

8" @ 250 Anhy 625 drlg. 2130

J. G. McGEHEE

County Barton State Kan
 Sec. 9 (Blk. 20) (Sur. 12W) Map No.
 Operator Lee Phillips
 Well No. 1 Farm Dahm
 Elev. 1820 Location SW SW NE



330 Ft. From S Line NE
330 Ft. From W Line Quarter
 1st. Report
 Completion JUN 23 1954
 Remarks Wildcat

Spudding Date 6-10-54
 Drlg. Data D & A TD 3420

8" @ 250 Anhy 625 Top. 2755
Heeb. 3006 Tor. 3031 Br. lime 3125
Lans. 3139 Cong. 3382 Arb. 3410
TD 3420

D & A

J. G. McGEHEE