


Section 11 Township 20 Range 12-W

Well No. #1 Fee

Company Fred Steckel

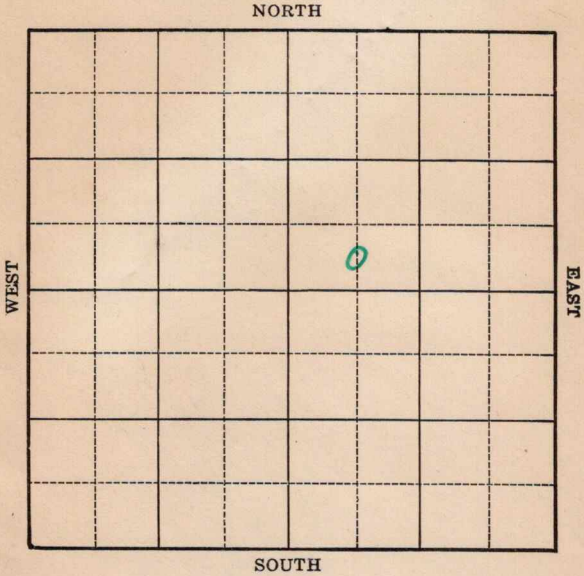

Sec. 11 Twp. 20 R. 12 -W

Well No. #1 Fee Farm _____

Fred Steckel Company _____

(Marchand)


_____ Ft. from N. Line

330 Ft. from S. Line

_____ Ft. from E. Line

660 Ft. from W. Line

Elev. 1796

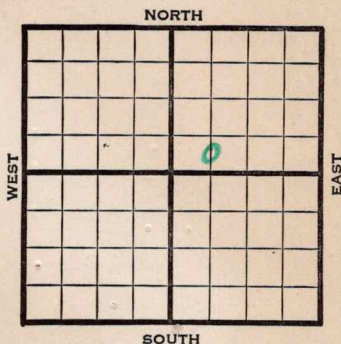

1940	REPORT
12/23	Location
1941	
1/2	"
1/9	Derrick.
1/16	"
1/23	8" - 105' Anhy 695'
	Drlg. 2031'
1/30	Arb. 3353-56' T.D. 5" - 3353'
	RUST.
2/6	T.D. 3379' 100' oil.
	1500 acid. No help.
2/13	T.D. 3381' 400' oil 72 hours.
	Shut down.
2/20	" "
2/27	" "
3/6	" "
3/13	" "
3/20	1530' oil in 33 days.
3/27	" " " "
4/3	" " " "
4/10	" " " "

OVER

741624

1941

4/18 1530' oil in 33 days.

4/24 " " "

5/1 " " "

5/8 " " "

5/14 Arb. 3353'

5" - 3353'

T.D. 3381'

2700 acid.

Water.

ABANDONED ABANDONED

Map No. 46 Sec. 11 Twp. 20 R. 12W

Well No. 1 Fee

Fred Steckel Company

Contractor

FIRST REPORT

SECTION PLAT

C S L SW NE

 Ft. from N. Line

330 Ft. from S. Line

 Ft. from E. Line

660 Ft. from W. Line

		o	

MARCHAND POOL

Location X

Rig up

Drilling and Remarks:

RECORD

Cased in., ft.

Sand

Gas

Oil

Total Depth

PRODUCTION

1st 24 hrs. Nat.

1st 24 hrs. after shot

Gas Cu. Ft.

Dry Hole

Abandoned

Date

DEC 23 1940 19

S. J. LEWIS Scout

Map No. 46 Sec. 11 Twp. 20 R. 12W

Well No. 1 Fee

Fred Steckel _____ Company

Contractor

ABANDONED

C S L SW NE

SECTION PLAT

_____ Ft. from N. Line

330 Ft. from S. Line

_____ Ft. from E. Line

660 Ft. from W. Line

MARCHAND POOL

Location _____

Rig up _____

Drilling and Remarks:

Cr X 3353
5" " 3353
2700 acid
Water

RECORD

Cased _____ in., _____ ft.

Sand _____

Gas _____

Oil _____

Total Depth 3381

PRODUCTION

1st 24 hrs. Nat. _____

1st 24 hrs. after shot _____

Gas _____ Cu. Ft.

Dry Hole _____

Abandoned _____

Date

MAY 14 1941 19

S. J. LEWIS Scout