

KANSAS

Cowley

Section 20 Township 31 Range 6E

Well No. 1 Hill "B"

Company Texas

Misc.

NORTH

WEST

EAST

			0				

SOUTH

Cowley

KANSAS ✓

Sec. 20 Twp. 31 R. 6E

Well No. #1 Hill "B" Farm

Texas

Company

Miscellaneous


Ft. from N. Line

330' Ft. from S. Line

330' Ft. from E. Line

Ft. from W. Line

SE NW

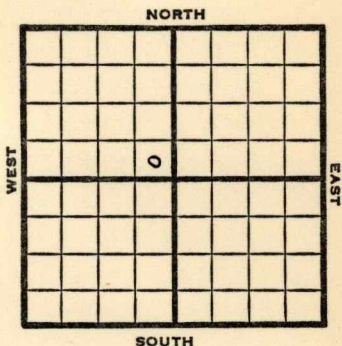

1949

Elev 1403'

REPORT

9/21 Location

9/28 "

10/5 10" @ 119'

Drlg 210'

10/12 Drlg 2565'

10/19 TD 2987'

Miss 2960'

Aband.

ABANDONED

Map No. _____ Sec. 20 Twp. 31 R. 6E

Well No. 1 Hill "B"


Texas

Company

Contractor

SE NW

FIRST REPORT
SECTION PLAT

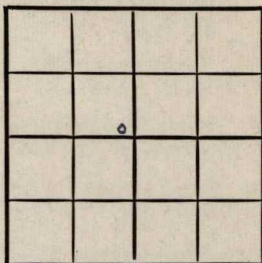

_____ Ft. from N. Line

330 _____ Ft. from S. Line

330 _____ Ft. from E. Line

_____ Ft. from W. Line

Cowley County

RECORD

Location X

Cased _____ in., _____ ft.

Rig up

Sand _____

Drilling and Remarks:

Gas _____

Oil _____

Total Depth _____

PRODUCTION

1st 24 hrs. Nat. _____

1st 24 hrs. after shot _____

Gas _____ Cu. Ft.

Dry Hole _____

Abandoned _____

Date

SEP 21 1949 19

S. J. LEWIS

Scout

Map No. _____ Sec. 20 Twp. 31 R. 6E

Well No. 1 Hill "B"

Texas

Company _____

ABANDONED

Contractor _____

SE NW

E/1403
 SECTION PLAT

_____ Ft. from N. Line

330 Ft. from S. Line

330 Ft. from E. Line

_____ Ft. from W. Line

Cowley County

Location _____

Rig up _____

Drilling and Remarks:

Miss 2960

RECORD

Cased _____ in., _____ ft.

Sand _____

Gas _____

Oil _____

Total Depth 2987

PRODUCTION

1st 24 hrs. Nat. _____

1st 24 hrs. after shot _____

Gas _____ Cu. Ft.

Dry Hole _____

Abandoned _____

Date

OCT 19 1949

S. J. LEWIS Scout