


Cowley
 Map No. **KANSAS** Sec. *20* Twp. *31* R. *6 E*
 Well No. *1-"B"* Farm
Lewis & Empire Company

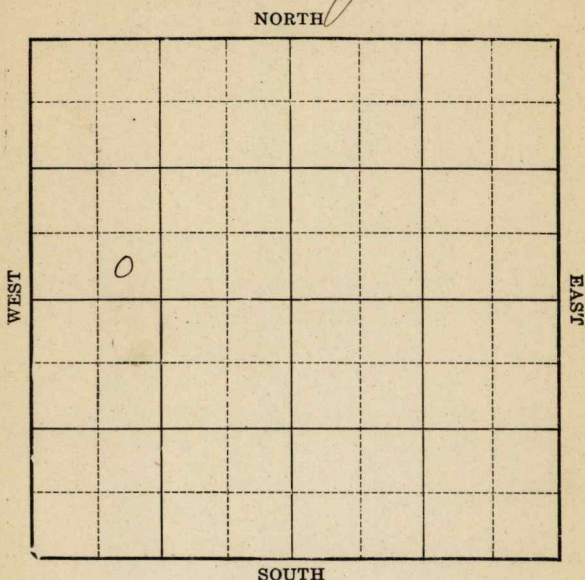

Location _____
 Drilling Remarks _____

Rig Up _____
 Drilling Remarks _____

RECORD


Cased _____ in. _____ ft.
 Sand _____
 Gas _____
 Oil _____
 Total Depth _____

PRODUCTION

1st 24 hrs. Nat. _____
 1st 24 hrs. after shot _____
 Gas _____ cu. ft.
 Dry Hole _____
 Abandoned _____

Map No. *Cowles* **KANSAS** Sec. *20* Twp. *31* R. *6 E*
 Well No. *1-"B" Hill* Farm _____
Lewis & Empire Company _____

_____ Ft. from N. Line
300 Ft. from S. Line
 _____ Ft. from E. Line
940 Ft. from W. Line
1430

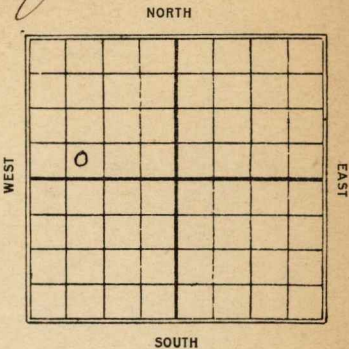

Date	REPORT
6/14	Loc
6/11	Bldg. rig
6/18	Regn up
6/25	Wrlg. 305'
7/2	" 1425'
7/9	" 1720'
7/16	Sand 1985-2010'
	2M gas. Wrlg. 2235'
7/23	Wrlg. 2875'
7/30	Sand 2840-2910'
	TD 2919'
	Shot 40 qt
	70 bbl oil
	Comp.

2 **KANSAS** Map No. Sec. 20 Twp. 31 R. 6^E

Well No. 1 "B" Hill

Lewis & Empire Company

Contractor

FIRST REPORTS

SECTION PLAT

_____ Ft. from N. Line

300 Ft. from S. Line

_____ Ft. from E. Line

910 Ft. from W. Line

Location ☒

Rig up _____

Drilling and Remarks:

80 feet west of
#1 gas well.

RECORD

Cased _____ in., _____ ft.

Sand _____

Gas _____

Oil _____

Total Depth _____

PRODUCTION

1st 24 hrs. Nat. _____

1st 24 hrs. after shot _____

Gas _____ Cu. Ft.

Dry Hole _____

Abandoned _____

Date
JUN 4 1930

19

CHAS. L. SHERWOOD

Scout

K2

Form 26—1M Bks.—2-29

Cowley

KANSAS

Map No. _____ Sec. 20 Twp. 31 R. 6

Well No. 1 "B" Hill

Lewis & Empire

Company

Contractor

COMPLETE

SECTION PLAT

_____ Ft. from N. Line

300 Ft. from S. Line

_____ Ft. from E. Line

910 Ft. from W. Line

Location _____

Rig up _____

Drilling and Remarks:

40 / 70 Bls

RECORD

Cased _____ in., _____ ft.

Sand 2890-2910

Gas _____

Oil _____

Total Depth 2919

PRODUCTION

1st 24 hrs. Nat. _____

1st 24 hrs. after shot _____

Gas _____ Cu. Ft.

Dry Hole _____

Abandoned _____

Date

JUL 30 1930

19

CHAS. L. SHERWOOD

Scout