


ELK

Map No. Kansas Sec. 4 Twp. 30 R. 10^E

Well No. 1 Joplynn Farm
Superior oil Company

250 Ft. from N. Line
..... Ft. from S. Line
250 Ft. from E. Line
..... Ft. from W. Line

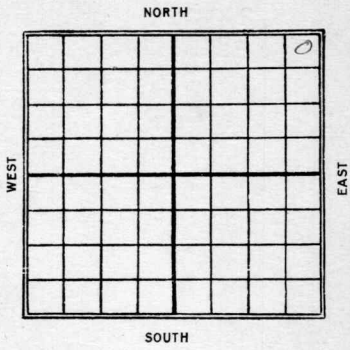

Date
1927

REPORT

1/8

Abandoned 2240

ELK 30 10 E

9 KANSAS

Map No. _____ Sec. 4 Twp. 30 R. 10

Well No. 1 Zepher Company

Superior Oil Co

Company

Contractor

FIRST REPORTS

SECTION PLAT

250 Ft. from N. Line

_____ Ft. from S. Line

250 Ft. from E. Line

_____ Ft. from W. Line

COMPLETED

			0
ABANDONED			

Location _____

Rig up _____

Drilling and Remarks:

RECORD

Cased _____ in., _____ ft.

Sand _____

Gas _____

Oil _____

Total Depth 2240

PRODUCTION

1st 24 hrs. Nat. _____

1st 24 hrs. after shot _____

Gas _____ Cu. Ft.

Dry Hole ✓

Abandoned ✓

Date

JAN 8 1927

CHAS. L. SHERWOOD

192

Scout