


Map No. _____ Sec. 27 Twp. 17 R. 6

Well No. 1 Madison Farm

Map No. _____ Sec. _____ Twp. _____ R. _____
Well No. 1- Martin Farm _____
Mission Oil Co Company _____

NORTH

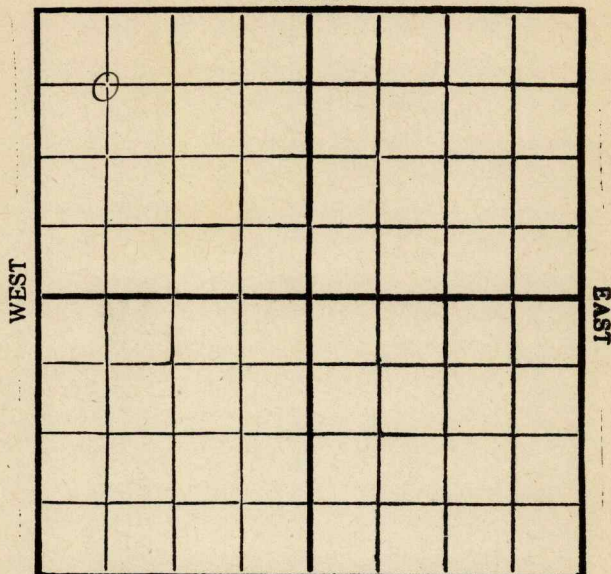

SOUTH

Location _____

Drilling Remarks

Rig Up _____

Drilling Remarks

RECORD

Cased _____ in. _____ ft.

Sand _____

Gas_____

Oil _____

Total Depth_____

PRODUCTION

1st 24 hrs. Nat. _____

1st 24 hrs. after shot_____

Gas _____ cu. ft. _____

Dry Hole_____

Abandoned _____

Map No. **KANSAS** Sec. 21 Twp. 31 R. 6^E


Well No. 1-Martin Farm
Mission Oil Company

660 Ft. from N. Line

_____ Ft. from S. Line

_____ Ft. from E. Line

660 Ft. from W. Line

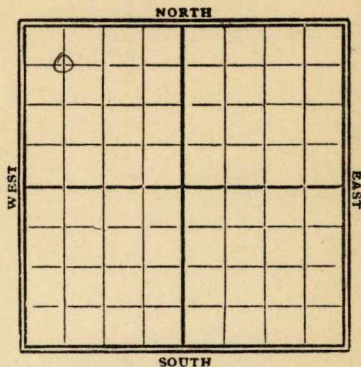

1929

Date

REPORT

11/13	Location
11/20	Machine
11/27	Ran up.
12/4	SD 830'
12/11	" 1530'
12/23	sand 1612-18'
12/30	5 1/4 M gas
1930	
1/8	—
1/15	—
1/22	SD 1618'
1/29	sand 1612-22'
	10 1/2 T.D. 1622'
	gas
	Pump.

2 **KANSAS** Cowley
 Map No. _____ Sec. 21 Twp. 31 R. 6 E

Well No. 1 Martin
 Mission Oil Co. _____ Company

 Contractor

FIRST REPORTS

SECTION PLAT

660 Ft. from N. Line

_____ Ft. from S. Line

_____ Ft. from E. Line

660 Ft. from W. Line

0			

Location _____ ✓

Rig up _____

Drilling and Remarks:

RECORD

Cased _____ in., _____ ft.

Sand _____

Gas _____

Oil _____

Total Depth _____

PRODUCTION

1st 24 hrs. Nat. _____

1st 24 hrs. after shot _____

Gas _____ Cu. Ft.

Dry Hole _____

Abandoned _____

Date

CHAS. L. SHERWOOD

11/13/29 192

Scout

Cawley

 Map No. 2 **KANSAS** Sec. 21 Twp. 31 R. 6
Well No. 1 MartinMission Oil Co Company

Contractor

COMPLETE

SECTION PLAT

0			

660 Ft. from N. Line

Ft. from S. Line

Ft. from E. Line

660 Ft. from W. Line

Location

Rig up

Drilling and Remarks:

RECORD

Cased 1612 in., 1622 ft.

Sand

Gas

Oil

Total Depth 1622

PRODUCTION

1st 24 hrs. Nat.

1st 24 hrs. after shot

Gas 10 1/4 Cu. Ft.

Dry Hole

Abandoned

Date

JAN 29 1930

192

CHAS. L. SHERWOOD

Scout