


Map No. **KANSAS** Sec. 21 Twp. 31 R. 6<sup>E</sup>

Well No. 2-Martin Farm \_\_\_\_\_  
Mission Oil Company \_\_\_\_\_

**NORTH**

WEST

EAST

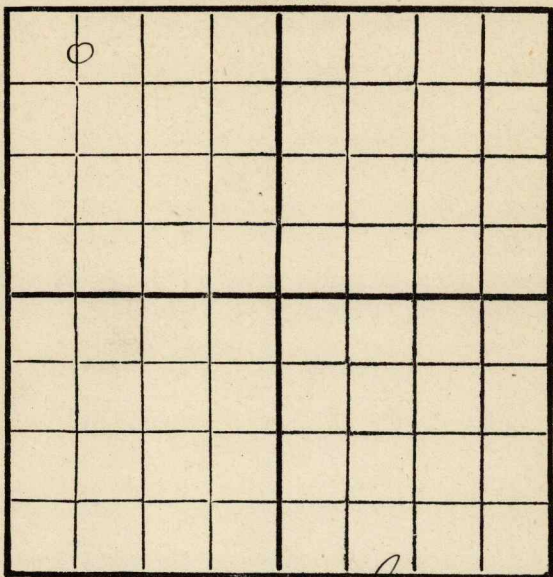

**SOUTH**

*Gas test*

Location \_\_\_\_\_  
Drilling Remarks \_\_\_\_\_  
\_\_\_\_\_  
\_\_\_\_\_  
Rig Up \_\_\_\_\_  
Drilling Remarks \_\_\_\_\_  
\_\_\_\_\_  
\_\_\_\_\_  
**RECORD**

Cased \_\_\_\_\_ in. \_\_\_\_\_ ft.  
Sand \_\_\_\_\_  
Gas \_\_\_\_\_  
Oil \_\_\_\_\_  
Total Depth \_\_\_\_\_

**PRODUCTION**

1st 24 hrs. Nat. \_\_\_\_\_  
1st 24 hrs. after shot \_\_\_\_\_  
Gas \_\_\_\_\_ cu. ft. \_\_\_\_\_  
Dry Hole \_\_\_\_\_  
Abandoned \_\_\_\_\_

Map No. **KANSAS** Sec. 21 Twp. 31 R. 6<sup>E</sup>

Well No. 2-Martin Farm

Mission Oil Company


450 Ft. from N. Line

\_\_\_\_\_ Ft. from S. Line

\_\_\_\_\_ Ft. from E. Line

660 Ft. from W. Line

1930

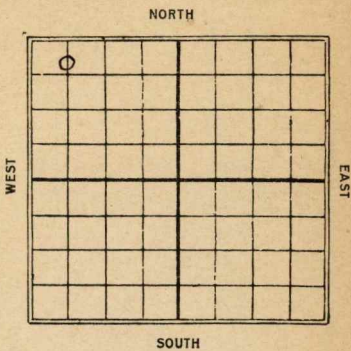

Date

REPORT

Gas test

1/29 Machine

2/4

2/11 Drilg. 535-

2/19 2 1250

2/26 Sand 1619-34' S.D  
10 ft gas & sho water

3/5 Sand 1619-1648-  
Graveling 8" 1652

3/12

3/19 10 ft Drilg. 1910'

3/26 6" - 2198

4/2 Sand 2206-2215  
2 1/2 ft gas S.D.

4/9

4/16 Sand 2206-18

TD 2218

5 1/2 ft gas

Comp.

*Cowley*

Map No. **2 KANSAS** Sec. *21* Twp. *31* R. *6<sup>E</sup>*

Well No. *2 Martin*  
*Mission Oil Co* Company

Contractor

**FIRST REPORTS**

**SECTION PLAT**

*450* Ft. from N. Line  
..... Ft. from S. Line  
..... Ft. from E. Line  
*660* Ft. from W. Line

0			

*for gas*

*Twin*

Location.....  
Rig up *Machins*.....  
Drilling and Remarks:

**RECORD**

Cased..... in., ..... ft.  
Sand.....  
Gas.....  
Oil.....  
Total Depth.....

**PRODUCTION**

1st 24 hrs. Nat.....  
1st 24 hrs. after shot.....  
Gas..... Cu. Ft.  
Dry Hole.....  
Abandoned.....

Date

**JAN 29 1930**

**CHAS. L. SHERWOOD**

192.....

Scout

Cowley

Map No. **KANSAS** Sec. 21 Twp. 31 R. 6

Well No. 2 Martin

Missnow Oil Co. Company

Contractor

**COMPLETE**

**SECTION PLAT**

450 Ft. from N. Line

Ft. from S. Line

Ft. from E. Line

660 Ft. from W. Line

0			

Location.....

Rig up.....

Drilling and Remarks:

**RECORD**

Cased..... in., ..... ft.

Sand 2206-2218

Gas.....

Oil.....

Total Depth 2218

**PRODUCTION**

1st 24 hrs. Nat.....

1st 24 hrs. after shot.....

Gas 5 1/2 M Cu. Ft.

Dry Hole.....

Abandoned.....

Date

APR 16 1930

192.....

**CHAS. L. SHERWOOD**

Scout