


Section 11 Township 18 Range 15W

Well No. 1 Maneth

Company Northern Ordnance

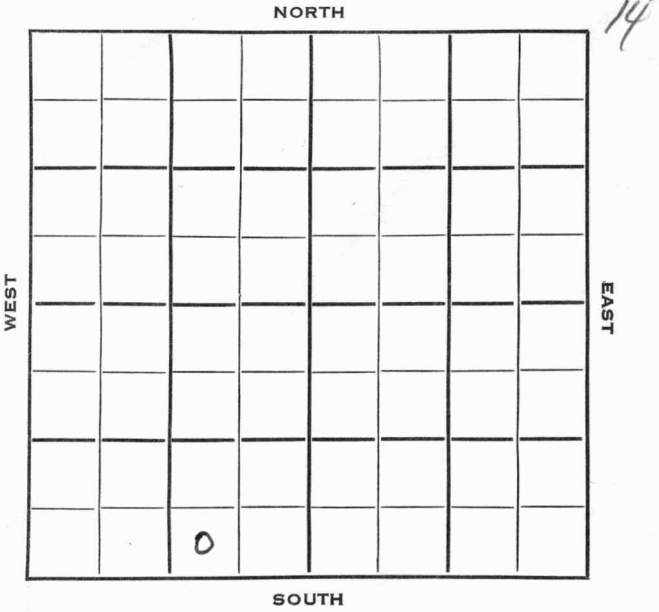

Barton

KANSAS ✓


SEC.	TWP.	R.
11	18	15W

WELL NO. **1 Maneth** FARM

COMPANY **Northern Ordnance**

CONTRACTOR **Northern Ord.
Wildcat**

_____ Ft. from N. Line
330 _____ Ft. from S. Line
990 _____ Ft. from E. Line
 _____ Ft. from W. Line

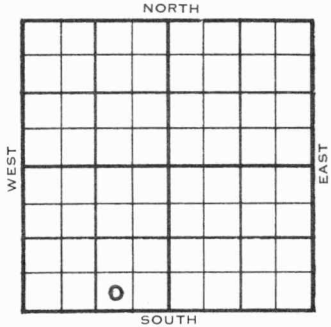

SW SE SW

1953	ELEVATION 1945'	REPORT
------	--------------------	--------

9/16 Spud 9-9-53
 8" @ 800'
 Drlg. 2300'

9/23 Spud 9-9-53
 D & A
 TD 3591'
 8" @ 800'
 Anhy 920, Heeb 3180, Br. Lime 3250,
 Lans 3266
 DST 3272-90 opn 3/4 hr, rec 460' sw,
 1110# Cong 3501', Arb 3541'
 TD 3591'
 D & A

ABANDONED

