

KANSAS


Form 51-5M-7-40-Palace

Barton

Section 17 Township 18 Range 15-W

Well No. #1 Schreiber

Company W. Fees & Hoyt

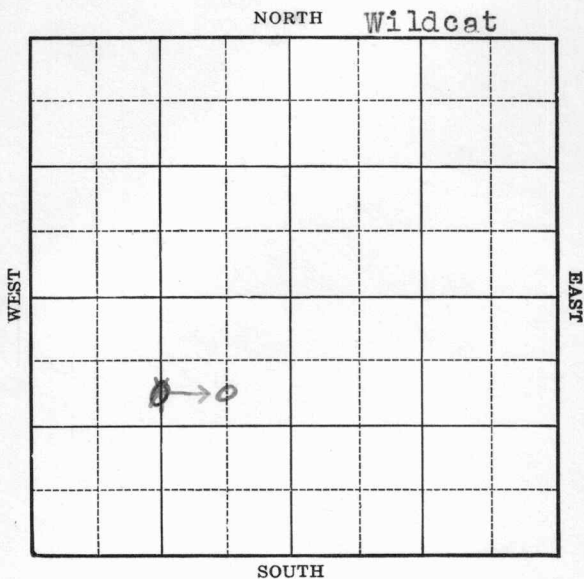

Sec. 17 Twp. 18 R. 15 -W

Well No. #1 Schreiber Farm

W. Fees & Hoyt Company

(Wildcat)


990 Ft. from N. Line

_____ Ft. from S. Line

660 Ft. from E. Line

1320 Ft. from W. Line

Elev. 1949

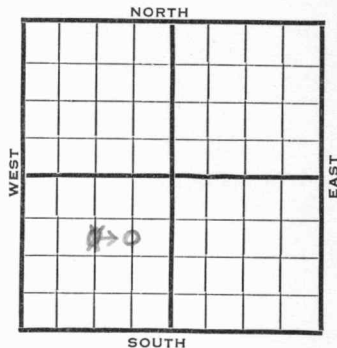

1940

REPORT

8/14 10" - 930' WOC.

8/22 Drlg. 2580'

8/29 Topeka 2930' Lans. 3240'

SSO 3294-3404' Reagan 3470-78'

T.D. 3478' Show gas.

5" - 3472' RUST.

9/4 Reagan 3470'

5" - 3472'

T.D. 3496'

35 M gas.

700# rock pressure.

COMPLETED

Map No. _____ Sec. **17** Twp. **18** R. **15W**

Well No. **1 Schreiber**

W. Fees & Hoyt Company

Contractor

C S L N $\frac{1}{2}$ SW

990 Ft. from N. Line

_____ Ft. from S. Line

_____ Ft. from E. Line

1320 Ft. from W. Line

SECTION PLAT

WILDCAT

Location _____

Rig up _____

Drilling and Remarks:

10" - 930
WOC

RECORD

Cased _____ in., _____ ft.

Sand _____

Gas _____

Oil _____

Total Depth _____

PRODUCTION

1st 24 hrs. Nat. _____

1st 24 hrs. after shot _____

Gas _____ Cu. Ft.

Dry Hole _____

Abandoned _____

Date

AUG 14 1940 19

S. J. LEWIS Scout

Map No. _____ Sec. 17 Twp. 18 R. 15W

Well No. 1 Schreiber

W. Fees & Hoyt

Company _____

CORRECTION

Contractor _____

SECTION PLAT

C S L NE SW

990 Ft. from N. Line

_____ Ft. from S. Line

660 Ft. from E. Line

_____ Ft. from W. Line

WILDCAT

Location _____

Rig up _____

Drilling and Remarks:

Reported

C S L N $\frac{1}{2}$ SW

RECORD

Cased _____ in., _____ ft.

Sand _____

Gas _____

Oil _____

Total Depth _____

PRODUCTION

1st 24 hrs. Nat. _____

1st 24 hrs. after shot _____

Gas _____ Cu. Ft.

Dry Hole _____

Abandoned _____

Date

AUG 21 1940

19

S. J. LEWIS Scout

Map No. _____ Sec. **17** Twp. **18** R. **15W**

Well No. **1 Schreiber**

W. Fees & Hoyt Company

Contractor

COMPLETED

SECTION PLAT

C S L NE SW
990 Ft. from N. Line
_____ Ft. from S. Line
_____ Ft. from E. Line
1320 Ft. from W. Line

WILDCAT

Location _____

Rig up _____

Drilling and Remarks:

Reagan 3470
5" @ 3472
3501 Gas.
700# Rock

RECORD

Cased _____ in., _____ ft.
Sand _____
Gas _____
Oil _____
Total Depth *3496*

PRODUCTION

1st 24 hrs. Nat. _____
1st 24 hrs. after shot _____
Gas _____ Cu. Ft.
Dry Hole _____
Abandoned _____

Date

SEP 4 1940 19 _____

S. J. LEWIS Scout