

KANSAS

Barton

Form 51-5M-7-39-Palace


Section 18 Township 18 Range 15-W

Well No. #1 Dirks

Company Hannum Drilling

NORTH

Albert Pool

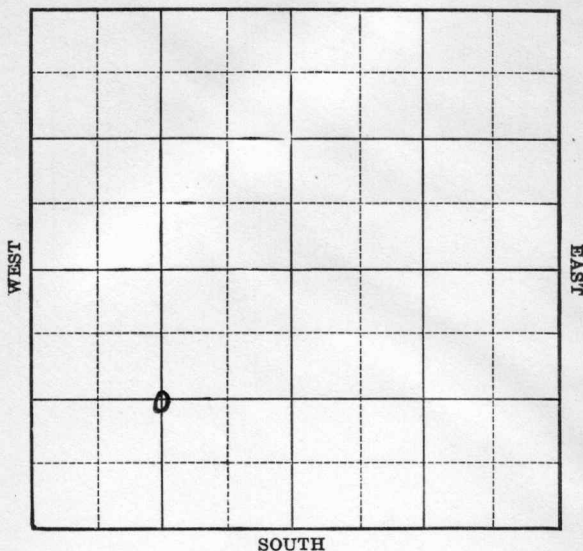

Sec. 18 Twp. 18 R. 15-W

Well No. #1 Dirks Farm _____

Hannun Drilling Company _____


(Albert)

_____ Ft. from N. Line

1320 Ft. from S. Line

_____ Ft. from E. Line

1320 Ft. from W. Line

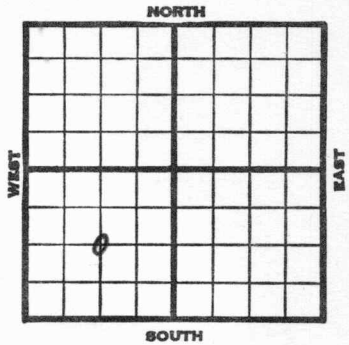

Elev. 1946

1940	REPORT
3/6	Cellar.
3/14	R.U.R.
3/21	13" - 210' Drlg. 410'
3/28	Drlg. 1920'
4/4	Drlg. 3079'
4/12	Cong. 3467' Reagan 3478'
	T.D. 3514' Run 5" - 3482'
4/18	5" - 3479' RUST.
4/25	" " "
5/2	T.D. 3515' Est. 48 M gas.
5/8	Reagan 3478'
	5" @ 3482'
	Total depth 3515'
	48,050,000 Gas.
	COMPLETED

Map No. 73 Sec. 18 Twp. 18 R. 15W

Well No. 1 Dirks

Hannum Drilling

Company

Contractor

FIRST REPORT
C SW

SECTION PLAT

_____ Ft. from N. Line

1320 Ft. from S. Line

_____ Ft. from E. Line

1320 Ft. from W. Line

Albert Pool

Location _____

RECORD

Rig up _____

Cased _____ in., _____ ft.

Drilling and Remarks:

Cellar

Sand _____

Gas _____

Oil _____

Total Depth _____

PRODUCTION

1st 24 hrs. Nat. _____

1st 24 hrs. after shot _____

Gas _____ Cu. Ft.

Dry Hole _____

Abandoned _____

Date

MAR 6 1940

19

S. J. LEWIS Scout

Map No. 73 Sec. 18 Twp. 18- R. 15WWell No. 1 Dirks

Hannum Drilling

Company

Contractor

COMPLETED

C SW

_____ Ft. from N. Line

1320 Ft. from S. Line

_____ Ft. from E. Line

1320 Ft. from W. Line

ALBERT POOL

SECTION PLAT

Location _____

Rig up _____

Drilling and Remarks:

*Reagan 3478.**5" @ 3482**48,050,000 Gas*

RECORD

Cased _____ in., _____ ft.

Sand _____

Gas _____

Oil _____

Total Depth 3515

PRODUCTION

1st 24 hrs. Nat. _____

1st 24 hrs. after shot _____

Gas _____ Cu. Ft.

Dry Hole _____

Abandoned _____

Date

MAY 8 1940 19S. J. LEWIS Scout