


Section 3 Township 18 Range 15 W

Well No. # 1 Maneth

Company Northern Pump Co.

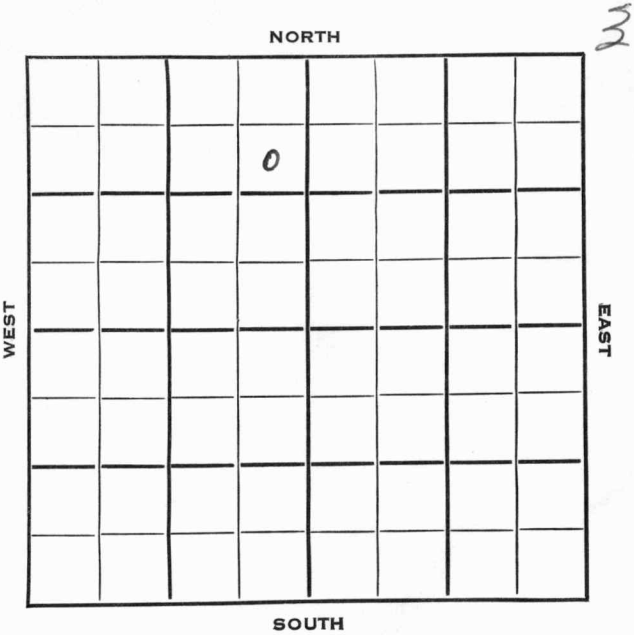

Barton

KANSAS ✓

SEC. 3	TWP. 18	R. 15W
-----------	------------	-----------

WELL NO.

1 Maneth

FARM

COMPANY

Northern Pump Co.

CONTRACTOR

Northern Pump
Wildcat


990 Ft. from N. Line

Ft. from S. Line

330 Ft. from E. Line

Ft. from W. Line

SE NE NW

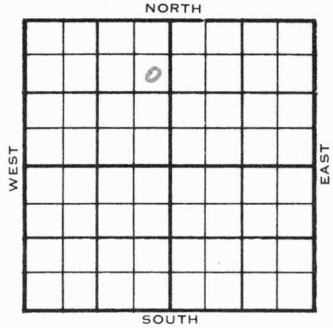

1953

ELEVATION

Elev. 1965'

REPORT

9/30

Spud 9-22-53
8" @ 765'
Drlg. 2408'


10/7

Heeb 3210' KC 3294'
Drlg. 3543'

10/14

Spud 9-22-53 D & A TD 3614
8" @ 765 Heeb 3210 KC 3294
Cong. 3510' Arb. 3558
TD 3614 D & A

ABANDONED

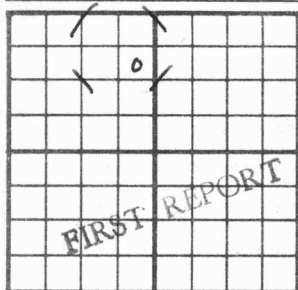County Barton State KansasSec. 3 (Blk.) 18 (Sur.) 15W Map No.Operator Northern Pump Co.Well No. 1 Farm ManethElev. Location SE NE NW990 Ft. From N Line NW330 Ft. From E Line Quarter1st. Report SEP 30 1953

Completion

Remarks

Northern Pump - Contr.Spudding Date 9-22-53Drlg. Data Wildcat8" @ 765 drlg. 2408

J. G. McGEHEE

