


Section 5 Township 18 Range 15W

Well No. #1 Ohnmacht

Company Northern Pump

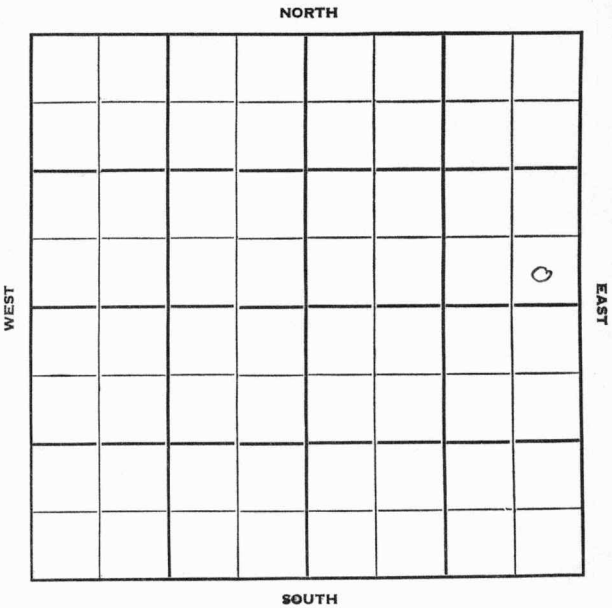

Barton

Sec. 5 Twp. 18 R. 15W

Well No. #1 Ohnmacht Farm

Northern Pump Company

Northern - Contr. Contractor

Wildcat


Ft. from N. Line

330' Ft. from S. Line

330' Ft. from E. Line

Ft. from W. Line

SE SE NE

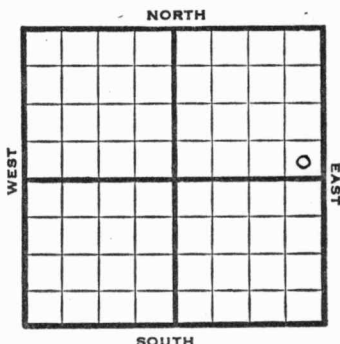


1952 Elev. 1972' REPORT

1/23 RUR  
2/6 Anhy 1015 Topeka 2975 Lans. 3288  
DST, Rec. mud DST 3306-20, 1 hr.  
50' W&M  
Drlg. 3327'

2/13 Spud 1-22-52  
D&A TD 3600  
8" @ 746 Anhy 1015  
Top 2975 Lans. 3288  
DST 3306-20 opn 1 hr.  
Rec. 50' wtr & mud  
Heeb. 3211 Br Lime 3276  
Cong. 3518 Arb. 3549  
DST 3549-57 opn 1/2 hr. Rec. 8' mud  
TD 3600 D&A

ABANDONED

County Barton State Kansas  
 Sec. 5 (Blk.) 18 (Sur.) 15W Map No.  
 (Twp.)  
 Operator Northern Pump  
 Well No. 1 Farm Ohnmacht  
 Elev. Location SE SE NE

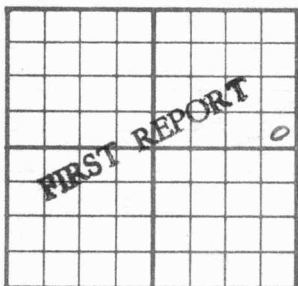


330 Ft. From S Line NE  
330 Ft. From E Line Quarter  
 1st. Report JAN 23 1952  
 Completion  
 Remarks  
Northern - Contr.  
 Spudding Date

Drlg. Data Wildcat

RUR

J. E. TYRA

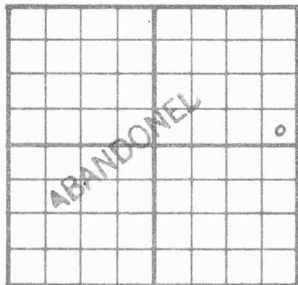County Barton State KansasSec. 5 (Blk.) 18 (Sur.) 15W Map No.Operator Northern PumpWell No. 1 Farm OhnmachtElev. 1972 Location SE SE NE330 Ft. From S Line NE330 Ft. From E Line Quarter

1st. Report

Completion FEB 13 1952Remarks WildcatSpudding Date 1-22-52Drlg. Data D & A TD 36008" @ 746 Anhy 1015 Top. 2975Lans. 3288 DST 3306-20 open 1 hr.Rec. 50' water & mud Heeb. 3211Br. lime 3276 Cong. 3518 Arb. 3549DST 3549-57 open  $\frac{1}{2}$  hr. Rec. 8' mudTD 3600 D & A