

KANSAS

Form 51—5M—7-39—Palace


Barton

Section 7 Township 18 Range 15-W

Well No. #1 Ford Estate

Company E. R. Rabon

NORTH Otis Gas Field

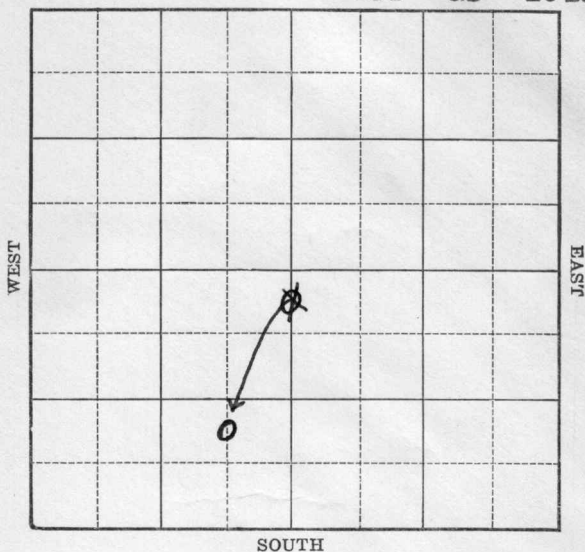

Sec. 7 Twp. 18 R. 15-WWell No. #1 Ford Estate FarmE. R. Rabon


Company

(Otis Gas Field)

330 Ft. from N. Line990 Ft. from S. Line2640 660 Ft. from E. Line

Ft. from W. Line

Elev. 2009

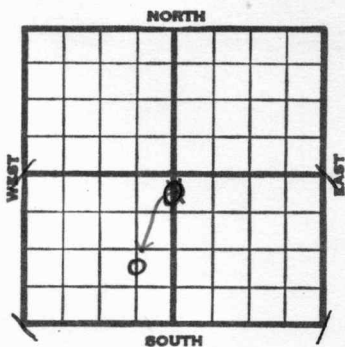

	REPORT
1939	
9/27	Cable.
10/5	"
10/12	12" - 393' T.D. 409' WOC.
10/19	Dakota Sand 472' H.F.W. Drlg. 815'
10/26	Anhy 1045' Drlg. 1245'
11/2	1 M gas 2385-90' 2400' run 8".
11/9	8" - 2404' Drlg. 2935'
11/16	Lans. 3290' T.D. 3385' Run 7".
11/23	7" - 3450' Drlg. 3488'
11/29	Reagan 3532' S.G. 7" - 3532' WOC.
12/6	Reagan 3535' 7" - 3532' T.D. 3538' 60 M cu. ft. gas. 708# R. Pr.
	COMPLETED

Barton

KANSAS

Map No. _____ Sec. 7 Twp. 18 R. 15WWell No. 1 Ford EstateE. R. Rabon

Company _____

Contractor _____

FIRST REPORT

C N L S $\frac{1}{2}$ 330 Ft. from N. Line


_____ Ft. from S. Line

2640 Ft. from E. Line

_____ Ft. from W. Line

OTIS GAS FIELD

SECTION PLAT

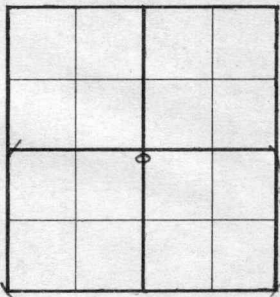

Location _____

Rig up _____

Drilling and Remarks:

Cable

RECORD

Cased _____ in., _____ ft.

Sand _____

Gas _____

Oil _____

Total Depth _____

PRODUCTION

1st 24 hrs. Nat. _____

1st 24 hrs. after shot _____

Gas _____ Cu. Ft.

Dry Hole _____

Abandoned _____

Date

SEP 27 1939

19

S. J. LEWIS

Scout

Map No. _____ Sec. 7 Twp. 18 R. 15WWell No. 1 Ford EstateE. K. Rabon

Company _____

CORRECTION

Contractor _____

C N L SE SW

SECTION PLAT

_____ Ft. from N. Line

990 Ft. from S. Line660 Ft. from E. Line

_____ Ft. from W. Line

OTIS GAS FIELD

Location _____

RECORD

Cased _____ in., _____ ft.

Sand _____

Gas _____

Oil _____

Total Depth _____

Rig up _____

Drilling and Remarks:

Reported:

C N L S $\frac{1}{2}$

PRODUCTION

1st 24 hrs. Nat. _____

1st 24 hrs. after shot _____

Gas _____ Cu. Ft.

Dry Hole _____

Abandoned _____

Date

OCT 4 1939

19

S. J. LEWIS

Scout

Map No. 73 Sec. 7 Twp. 18 R. 15WWell No. 1 Ford EstateE. K. Rabon

Company

Contractor

COMPLETED

C N L SE SW

 Ft. from N. Line990 Ft. from S. Line660 Ft. from E. Line Ft. from W. Line

OTIS GAS FIELD

SECTION PLAT

Location Rig up

Drilling and Remarks:

Ragan 3530-
7" @ 3532

60M Gas.

708# R. P.

RECORD

Cased in., ft.Sand Gas Oil Total Depth 3538

PRODUCTION

1st 24 hrs. Nat. 1st 24 hrs. after shot Gas Cu. Ft.Dry Hole Abandoned

Date

DEC 6 1939 19

S. J. LEWIS

Scout